

JAN 12 1996

COMMISSION

LAKE COUNTY REMONUMENTATION
LAND CORNER RECORDATION CERTIFICATE
Filing Requirement of Act 74, Mich. P.A. 1970

LIBER003 PAGE0287


For corners in

Lake (County)	Located In:		Corner Code #/
	18N	11W	
1. Public Land Survey	T _____	R _____	E-9
	T _____	R _____	
	T _____	R _____	
	T _____	R _____	
2. Property Controlling in Section	S _____	T _____	R _____
	S _____	T _____	R _____
3. Miscellaneous Property in Sec.	S _____	T _____	R _____
	S _____	T _____	R _____

REGISTER OF DEEDS
 JUN 8 3 50 PM '95
 REGISTERED
 LAKE COUNTY, MI.
 Register of Deeds Stamp & File Number

4. Lot No. _____, Recorded Plat _____
 5. Private Claims _____

I, Robert L. Wetherell, in a field survey on February 24, 1995, do hereby certify that under requirements of P.A. 74, Michigan P.A. of 1970, the corner points mentioned in lines 1 and 2 above were in conformance with regulations and rules therefore as required in the current manual of survey instructions of the United States Department of the Interior, Bureau of Land Management or by a decree of a Court of Law and/or that the corner points mentioned in lines 3, 4 and 5 above were in conformance with the rules of the Michigan Board of Land Surveyors or by a Decree of a Court of Law; established, re-established, monumented, re-monumented, recovered, found as expressed below:

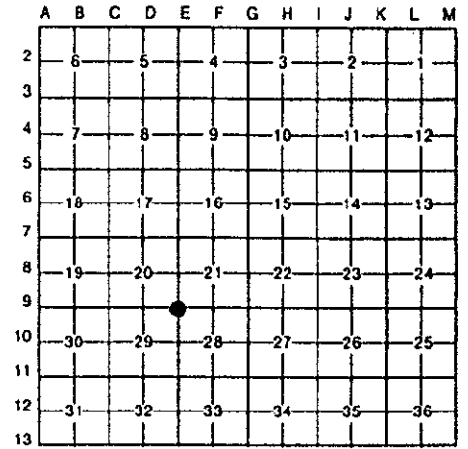

NOTE: Not more than 4 corners, all in the same town and range, may be recorded on this certificate.

A. Description of original monument and accessories and/or subsequent restoration:

- E-9 - Section corner common to Sections 20, 21, 28 & 29, T18N, R11W, Pinora Twp., Lake Co., Mi.
- | | | |
|---|---------------------------------------|--------------------------------------|
| <u>1837 - John Hodgson, G.L.O.</u> | <u>1961 - George Blass, L.S. 5489</u> | <u>1973 - Carl Roser, L.S. 12028</u> |
| #1 - 14" Pine N45°W 34 Links | 5/8" Boat Spike | L.C.R.C. - L. 02, Page 166. |
| #2 - 10" Pine S21°E 9 Links | #3 - 18" Oak N28°W 63.37' | Replaced Boat Spike with D.N.R. Mon. |
| | #4 - 5" Maple N57°E 63.53' | #4 - 8" Maple N57°E 63.4' |
| <u>1904 - Hollister, Deputy Co. Surv.</u> | #5 - 7" W. Oak S37°E 73.70' | #3 - 20" B. Oak N28°W 63.1' |
| Stone set in ground (no witnesses) | #6 - Fence Post S44°W 45.15' | #7 - P. Pole S48°E 49.3' |
| | | #8 Cedar Post N45°E 40' |

(SEE OVER FOR CONTINUATION OF "A")

B. Description of corner evidence found and/or method applied in restoring or reestablishing corner:

E-9 - Section corner common to Sections 20, 21, 28 & 29, T18N, R11W, Pinora Twp., Lake Co., Mi.

I found the D.N.R. monument 17" below surface of road intersection (East, West North and South). I also found accessory No. 3, which checked well with old records. All the other accessories had been destroyed with road improvements. There had been a severe cut in this area which probably destroyed the stone set by Hollister.

C. Description of monument for corner and accessories established to perpetuate locating the position of the corner:

E-9 - Section corner common to Sections 20, 21, 28 & 29, T18N, R11W, Pinora Twp., Lake Co., Mi.

I accepted the D.N.R. Monument as a substantial monument for the corner and is accepted as a careful and faithful re-establishment of the position of the original corner.

- 4" J. Pine N36°E 76.97' (60d spike in W. side)
- 8" W. Oak S49°E 115.08' (60d spike in S.W. side)
- 14" Tw. B. Oak S70°W 98.70' (60d spike in N. side)
- 20" B. Oak N24°W 63.75' (Found nail in E. side) O.B.T. No. 3

RATIFIED BY THE LAKE CO. PEER REVIEW GROUP
 IN ACCORDANCE WITH P.A. 236
 R.L.W. CHAIRMAN
 5-22-95 DATE

STATE OF MICHIGAN
 ROBERT L. WETHERELL
 SURVEYOR
 24624

FORM APPROVED BY MICHIGAN STATE BOARD OF LAND SURVEYORS, JAN 1994

Signed by Robert L. Wetherell Date May 29, 1995
 Surveyor's Michigan License No. 24624

LIBER 003 PAGE 0288

SURVEY &
REMONUMENTATION

JAN 12 1996

COMMISSION

CONTINUATION OF "A" - DESCRIPTION OF ORIGINAL MONUMENT AND ACCESSORIES AND/OR SUBSEQUENT RESTORATION:

1974 - John Meyers, L.S. 14099

L.C.R.C. Liber 02, Page 186

Found Concrete Monument

#3 - 18" Oak N28°W 63.37'

#4 - 5" Maple N57°E 63.53'

#5 - 7" Oak S37°E 73.70'