

NOV 21 1997

COMMISSION

LAND CORNER RECORDATION CERTIFICATE
Filing Requirement of Act 74, Mich. P.A. 1970

RECORDED LAKE COUNTY, MI. LIBER 004 PAGE 0051 SEP 12 10 32 AM '97 REGISTER OF DEEDS

For corners in

Table with columns: Lake (County), Located In: (18N, 11W), Corner Code ## (F-3). Rows include Public Land Survey, Property Controlling in Section, Miscellaneous Property in Sec.

Register of Deeds Stamp & File Number

- 4. Lot No. Recorded Plat
5. Private Claims

Grid table with columns A-M and rows 2-13. A dot is marked at the intersection of column F and row 4.

I, Robert L. Wetherell, in a field survey on May 15, 1997, do hereby certify that under requirements of P.A. 74, Michigan P.A. of 1970, the corner points mentioned in lines 1 and 2 above were in conformance with regulations and rules therefore as required in the current manual of survey instructions of the United States Department of the Interior, Bureau of Land Management or by a decree of a Court of Law and/or that the corner points mentioned in lines 3, 4 and 5 above were in conformance with the rules of the Michigan Board of Land Surveyors or by a Decree of a Court of Law; established, re-established, monumented, re-monumented, recovered, found as expressed below:

NOTE: Not more than 4 corners, all in the same town and range, may be recorded on this certificate.

A. Description of original monument and accessories and/or subsequent restoration:

F-3 - 1/4 Corner common to Sections 4 and 9, T18N, R11W, Lake Co., Mi.

1838 - John Hodgson, G.L.O.

#1 - 7" B. Oak S43°E 11 Links

#2 - 7" B. Oak N60°W 18 Links

1973 - James Fraus, LS 17089

L.C.R.C. Liber 02, Pg. 158

Set 1/2 Re-bar by single proportionate method.

#3 - 15" Oak S42°E 51.75'

#4 - 14" Oak S9°E 37.93'

#5 - 14" Oak S41°W 42.45'

1975 - Clinton E. Cole, LS 17615

Survey recorded in Liber 02, Pg. 110

#5 - 10 B. Oak S44°W 42.46'

#4 - 10" B. Oak S4°E 37.88'

#6 - 14" B. Oak N25°W 74.15'

B. Description of corner evidence found and/or method applied in restoring or reestablishing corner:

F-3 - 1/4 Corner common to Sections 4 and 9, T18N, R11W, Lake Co., Mi.

I found a 1/2" Re-bar 5 feet more or less South of the centerline of East and West Road. Measurement confirms that is halfway and on line between Section corners.

Condition of the accessories are as follows: #1 Gone, #2 Gone, #3 Found in good condition, #4 Gone, #5 Found dead, #6 Found in good condition.


RATIFIED BY THE LAKE CO. PEER REVIEW GROUP IN ACCORDANCE WITH P.A. 345 CHAIRMAN R.L.W. DATE 8-27-97

C. Description of monument for corner and accessories established to perpetuate locating the position of the corner:

F-3 - 1/4 Corner common to Sections 4 and 9, T18N, R11W, Lake Co., Mi.

I replaced the 1/2" Re-bar with a 3/4" x 24" Re-bar and Lake County Brass Cap, and is accepted as a careful and faithful re-establishment of the position of the original corner.

- 12" Tw. R. Oak S43°W 80.25' (60d spike in N.W. side)
16" B. Oak S38°E 51.71' (60d spike in N.E. side) #3
18" R. Oak N52°E 85.78' (60d spike in S.E. side)
15" W. Oak N23°E 58.55' (found nail in W. side)

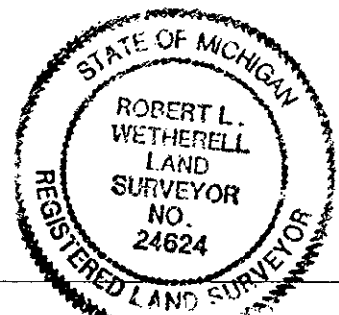

Signed by Robert L. Wetherell

Date 8-27-97

Surveyor's Michigan License No. 24624