

NOV 21 1997

COMMISSION

LAND CORNER RECORDATION CERTIFICATE  
Filing Requirement of Act 74, Mich. P.A. 1970

RECORDED  
LAKE COUNTY, MI.  
LIBER 004 PAGE 0050  
SEP 12 10 32 AM '97

*Shirley M. DeLoach*  
REGISTER OF DEEDS

For corners in


Lake (County)	Located In:		Corner Code #
	18N	11W	
1. Public Land Survey	T	R	G-3
	T	R	
	T	R	
	T	R	
2. Property Controlling in Section	S	T	
	S	T	
3. Miscellaneous Property in Sec.	S	T	
	S	T	

Register of Deeds Stamp & File Number

4. Lot No. \_\_\_\_\_, Recorded Plat \_\_\_\_\_  
5. Private Claims \_\_\_\_\_

Robert L. Wetherell May 15, 97

I, \_\_\_\_\_, in a field survey on \_\_\_\_\_, 19\_\_\_\_, do hereby certify that under requirements of P.A. 74, Michigan P.A. of 1970, the corner points mentioned in lines 1 and 2 above were in conformance with regulations and rules therefore as required in the current manual of survey instructions of the United States Department of the Interior, Bureau of Land Management or by a decree of a Court of Law and/or that the corner points mentioned in lines 3, 4 and 5 above were in conformance with the rules of the Michigan Board of Land Surveyors or by a Decree of a Court of Law; established, re-established, monumented, re-monumented, recovered, found as expressed below:

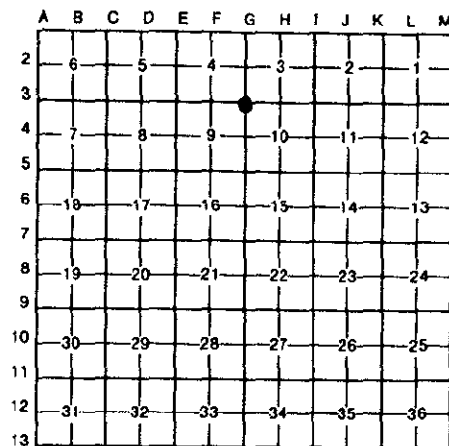

NOTE: Not more than 4 corners, all in the same town and range, may be recorded on this certificate.

Description of original monument and accessories and/or subsequent restoration:

G-3 - Section corner common to Sections 3, 4, 9 & 10, T18N, R11W, Lake Co., Mi.

- 1838 - John Hodgson, G.L.O.
- #1 - 8" Beech S88°E 19 Links
- #2 - 8" Beech S74°W 53 Links
- Undated - George Johnson, Co. Sur.
- #3 - 14" Pine Stump S45°W 38'
- #4 - 16" pine Stump N19°E 55'
- 1972 - James Fraus, LS 17089
- L.C.R.C. - Liber 02, Pg. 158
- Found 1/2" Bar
- #5 - P. Pole N60°E 92.39'
- #6 - 12" Oak S45°E 51.38'
- #7 - Monument - North 33.00'

- 1973 - Carl Roser, DNR, LS 12028
- L.C.R.C. - Liber 02, Page 169
- Restored corner from (2) Frank Jones witnesses and (1) George Johnson witness. Set D.N.R. Monument
- #8 - 17" W. Oak N50°E 93.7'
- #9 - 16" W. Oak S13°E 87.0'
- #10 - 9" Maple S60°W 87.7'
- #11 - Post - North 33.00'

Description of corner evidence found and/or method applied in restoring or reestablishing corner:

G-3 - Section corner common to Sections 3, 4, 9 & 10, T18N, R11W, Lake Co., Mi.

I found the D.N.R. Monument 1.5 feet South of centerline of East and West road and 30 feet West of road to the North.

Condition of the accessories are as follows: #1 Gone, #2 Gone, #3 Gone, #4 Gone, #5 Found in good condition, #6 Found in good condition, #7 Found in good condition, #8 Gone, #9 Found in good condition, #10 Found stump, #11 Gone.

RATIFIED BY THE LAKE CO. PEER REVIEW GROUP  
IN ACCORDANCE WITH P.A. 345

CHAIRMAN *R.L.W.*  
DATE *8-27-97*

Description of monument for corner and accessories established to perpetuate locating the position of the corner:


G-3 - Section corner common to Sections 3, 4, 9 & 10, T18N, R11W, Lake Co., Mi.

I accepted the D.N.R. Monument as a substantial marker for the corner, and is accepted as a careful and faithful re-establishment of the position of the original corner.

- 19" W. Oak S13°E 87.43' (60d spike in W. side) #9
- 20" Tw. R. Oak S34°E 51.43' (60d spike in N.E. side) #6
- 8" Tw. R. Oak N4°E 102.30' (60d spike in W. side)
- 7" W. Oak N68°W 98.63' (60d spike in S. side)
- Concrete Monument N4°W 33.07' #7

Red by *Robert L. Wetherell*  
24624

Date *8-27-97*

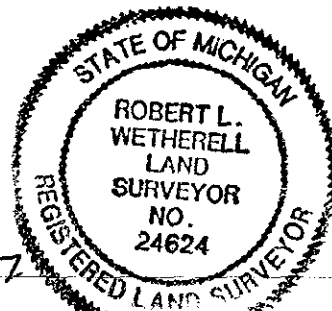

Surveyor's Michigan License No. \_\_\_\_\_