

JAN 12 1996

COMMISSION

LAKE COUNTY REMONUMENTATION LAND CORNER RECORDATION CERTIFICATE Filing Requirement of Act 74, Mich. P.A. 1970


LIBER 003 PAGE 0290

For corners in

Table with columns: Lake (County), Located In: (18N, 11W), Corner Code (#). Rows include Public Land Survey, Property Controlling in Section, Miscellaneous Property in Sec., Lot No., and Private Claims.

REGISTER OF DEEDS stamp with date JUN 8 3 50 PM '95 and LAKE COUNTY, MI. REGISTERED RECORD.

I, Robert L. Wetherell, in a field survey on February 24, 1995, do hereby certify that under requirements of P.A. 74, Michigan P.A. of 1970, the corner points mentioned in lines 1 and 2 above were in conformance with regulations and rules therefore as required in the current manual of survey instructions of the United States Department of the Interior, Bureau of Land Management or by a decree of a Court of Law and/or that the corner points mentioned in lines 3, 4 and 5 above were in conformance with the rules of the Michigan Board of Land Surveyors or by a Decree of a Court of Law; established, re-established, monumented, re-monumented, recovered, found as expressed below:

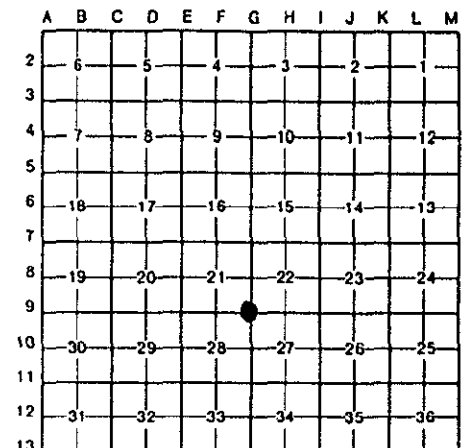

NOTE: Not more than 4 corners, all in the same town and range, may be recorded on this certificate.

A. Description of original monument and accessories and/or subsequent restoration:

- G-9 - Corner common to Sections 21, 22, 27 & 28, T18N, R11W, Pinora Twp., Lake Co., Mi. 1837 - John Hodgson, G.L.O. 1961 - George Blass, L.S. 5489 1973 - Carl Roser, L.S. 12028


B. Description of corner evidence found and/or method applied in restoring or reestablishing corner:

G-9 - Corner common to Sections 21, 22, 27 & 28, T18N, R11W, Pinora Twp., Lake Co., Mi. I found a 4" x 36" Concrete Monument and all the above accessories. This corner is basically at the extension of the centerline of a North and South County Road that curves Westerly approximately 600 feet South of the corner.

C. Description of monument for corner and accessories established to perpetuate locating the position of the corner:

- G-9 - Corner common to Sections 21, 22, 27 & 28, T18N, R11W, Pinora Twp., Lake Co., Mi. I accepted the 4" x 36" Concrete Monument as a substantial monument for the corner and is accepted as a careful and faithful re-establishment of the position of the original corner. 18" R. Oak N44°W 25.40' (60d spike in N.E. side) O.B.T. #1 32" R. Oak N27°E 18.45' (60d spike in W. side) O.B.T. #2 16" Tw. Maple S51°W 25.88' (60d spike in N.E. side) O.B.T. #3 5" Red Oak S50W 25.88' ((60d spike in N.W. side) 6" Cedar Post N.W. 2' (D.N.R. Location - Tag on Post).

PATIFIED BY THE LAKE CO. PEER REVIEW GROUP IN ACCORDANCE WITH P.A. 345 CHAIRMAN R. X. W. DATE 5-22-95

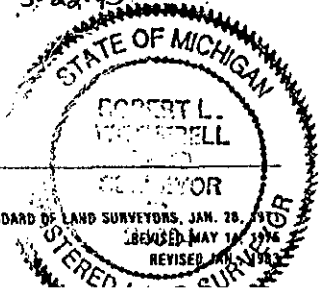

signed by Robert L. Wetherell Surveyor's Michigan License No. 24624

Date May 29, 1995