

NOV 15 1994

COMMISSION

LAND CORNER RECORDATION CERTIFICATE
Filing Requirement of Act 74, Mich. P.A. 1970

LIBER 003 PAGE 0256

For corners in Lake

Table with columns: (County), Located In: (18N, 11W), Corner Code # (6-13). Rows include Public Land Survey, Property Controlling in Section, and Miscellaneous Property in Sec.

REGISTER OF DEEDS

Handwritten signature

OCT 27 3 24 PM '94

RECORDED LAKE COUNTY, MI.

Register of Deeds Stamp & File Number

- 4. Lot No. , Recorded Plat
5. Private Claims

Grid table with columns A-M and rows 2-13. A dot is marked in row 13, column G.

I, Robert L. Wetherell, in a field survey on October 10, 1994, do hereby certify that under requirements of P.A. 74, Michigan P.A. of 1970, the corner points mentioned in lines 1 and 2 above were in conformance with regulations and rules therefore as required in the current manual of survey instructions of the United States Department of the Interior, Bureau of Land Management or by a decree of a Court of Law and/or that the corner points mentioned in lines 3, 4 and 5 above were in conformance with the rules of the Michigan Board of Land Surveyors or by a Decree of a Court of Law; established, re-established, monumented, re-monumented, recovered, found as expressed below:


NOTE: Not more than 4 corners, all in the same town and range, may be recorded on this certificate.

A. Description of original monument and accessories and/or subsequent restoration:

- G-13 - Section Corner common to Sections 33 and 34, Pinora Twp., Lake Co., Mi., on the township line.
1837 - John Hodgson, G.L.O.
1979 - Robert L. Wetherell, LS 24624
1988 - Robert L. Wetherell, LS 24624
#1 - 12" Beech N61°E 28 Links
Set 1/2" Re-bar for corner G.L.O. Survey Certificate showing corner record distance from closing corner. 9.24' East of closing corner.
#2 - 7" Beech N52°W 24 Links
#3 - Re-bar West 9.24' (Closing corner)
1930 - George Johnson, Co. Surveyor
Making road survey measured
2638 feet East to 1/4 post.
1986 - Jack Pierson, LS 19305
#4 - P. Pole S47°E 62.17'
#5 - P. Pole N60°W 143.05'

B. Description of corner evidence found and/or method applied in restoring or reestablishing corner:

G-13 - Section Corner common to Sections 33 and 34, Pinora Twp., Lake Co., Mi., on the township line.
Found 1/2" re-bar with cap marked LS 24624, condition of the accessores are as follows:
#1 Gone, #2 Gone, #3 Found in good condition, #4 Found in good condition, # 5 Gone (new pole has been set).

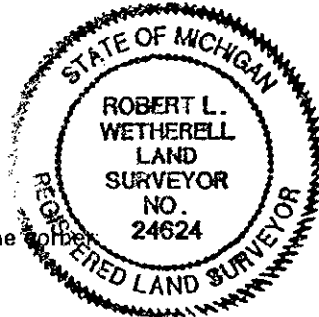

C. Description of monument for corner and accessories established to perpetuate locating the position of the corner:

G-13 - Section Corner common to Sections 33 and 34, Pinora Twp., Lake Co., Mi., on the township line.
I set a 3/4" x 24" re-bar with a Lake County Brass Cap, and is accepted as a careful and faithful re-establishment of the position of the original corner.
P. Pole N60°W 141.15' (60d spike in S.W. side) (#5)
24" Maple S14°W 260.90' (60d spike in W. side of tree)
P. Pole S45°E 62.17' (60d spike in N.E. side) (#4)
Section corner common to Sections 3 & 4, T17N, R11W, West 9.24' (3/4" x 24" re-bar with Lake County Brass Cap)

Signed by Robert L. Wetherell Date 10-26-94

Surveyor's Michigan License No. LS 24624
RATIFIED BY THE LAKE CO. PEER REVIEW GROUP
IN ACCORDANCE WITH P.A. 345
CHAIRMAN G.P.W.
DATE 10-25-94