

NOV 21 1997

COMMISSION

RECORDED LAKE COUNTY, MI.

LIBER 004 PAGE 0052 SEP 12 10 32 AM '97

LAND CORNER RECORDATION CERTIFICATE Filing Requirement of Act 74, Mich. P.A. 1970

REGISTER OF DEEDS

For corners in

Table with columns: Lake (County), Located In: (18N, 11W, H-3), Corner Code #. Rows include Public Land Survey, Property Controlling in Section, and Miscellaneous Property in Sec.

Register of Deeds Stamp & File Number

4. Lot No. , Recorded Plat
5. Private Claims

Grid map showing sections 1-36 in a 6x6 layout with columns A-M and rows 1-13.

I, Robert L. Wetherell, in a field survey on May 15, 1997, do hereby certify that under requirements of P.A. 74, Michigan P.A. of 1970, the corner points mentioned in lines 1 and 2 above were in conformance with regulations and rules therefore as required in the current manual of survey instructions of the United States Department of the Interior, Bureau of Land Management or by a decree of a Court of Law and/or that the corner points mentioned in lines 3, 4 and 5 above were in conformance with the rules of the Michigan Board of Land Surveyors or by a Decree of a Court of Law; established, re-established, monumented, re-monumented, recovered, found as expressed below:

NOTE: Not more than 4 corners, all in the same town and range, may be recorded on this certificate.

A. Description of original monument and accessories and/or subsequent restoration:

H-3 - 1/4 Corner common to Sections 3 and 10, T18N, R11W, Lake Co., Mi.

1838 - John Hodgson, G.L.O.

#1 - 14" Beech S30°W 23 Links

#2 - 9" Beech N64°W 11 Links

1972 - James Fraus, LS 17089

Liber 02, Page 157

Set 1/2 Bar at intersection of occupied North and South 1/4 line and South line of Section 3

#3 - 8" Poplar N45°E 45.84'

#4 - 6" Post South 33.78'

#5 - 12" Oak N45°W 39.98'

B. Description of corner evidence found and/or method applied in restoring or reestablishing corner:

H-3 - 1/4 Corner common to Sections 3 and 10, T18N, R11W, Lake Co., Mi.

I found a 1/2" Iron 2 feet North of centerline of East and West road and in old fence line to the South.

Condition of the accessories are as follows: #1 Gone, #2 Gone, #3 Gone, #4 Found down, #5 Gone.

RATIFIED BY THE LAKE CO. PEER REVIEW GROUP IN ACCORDANCE WITH P.A. 845 CHAIRMAN R.L.W. DATE 8-27-97

C. Description of monument for corner and accessories established to perpetuate locating the position of the corner:

H-3 - 1/4 Corner common to Sections 3 and 10, T18N, R11W, Lake Co., Mi.


Replaced the 1/2" Iron with a 3/4" x 24" Re-bar and Lake County Brass Cap, and is accepted as a careful and faithful re-establishment of the position of the original corner.

9" W. Pine S24°E 45.11 (60d spike in W. side)

22" W. Oak S18°W 31.41' (60d spike in E. side)

7" W. Oak N29°E 31.63' (60d spike in W. side)

8" Cherry N24°W 31.79' (60d spike in W. side)

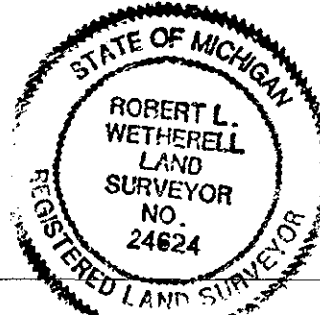

Signed by Robert L. Wetherell

Date 8-27-97

Surveyor's Michigan License No. 24624