

NOV 15 1994

COMMISSION

LAND CORNER RECORDATION CERTIFICATE  
Filing Requirement of Act 74, Mich. P.A. 1970

LIBER 003 PAGE 0257

For corners in

Lake (County)	Located In:	Corner Code #
1. Public Land Survey	T 18N R 11W	H-13
	T R	
	T R	
	T R	
2. Property Controlling in Section	S T R	
	S T R	
3. Miscellaneous Property in Sec.	S T R	
	S T R	

RECORDED  
LAKE COUNTY, MI.  
OCT 27 3 24 PM '94  
REGISTER OF DEEDS  
Register of Deeds Stamp & File Number

- 4. Lot No. \_\_\_\_\_, Recorded Plat \_\_\_\_\_
- 5. Private Claims \_\_\_\_\_

I, Robert L. Wetherell, in a field survey on October 10, 19 94, do hereby certify that under requirements of P.A. 74, Michigan P.A. of 1970, the corner points mentioned in lines 1 and 2 above were in conformance with regulations and rules therefore as required in the current manual of survey instructions of the United States Department of the Interior, Bureau of Land Management or by a decree of a Court of Law and/or that the corner points mentioned in lines 3, 4 and 5 above were in conformance with the rules of the Michigan Board of Land Surveyors or by a Decree of a Court of Law; established, re-established, monumented, re-monumented, recovered, found as expressed below:

	A	B	C	D	E	F	G	H	I	J	K	L	M
2	6		5		4		3		2		1		
3													
4	7		8		9		10		11		12		
5													
6	18		17		16		15		14		13		
7													
8	19		20		21		22		23		24		
9													
10	30		29		28		27		26		25		
11													
12	31		32		33		34		35		36		
13													

**NOTE: Not more than 4 corners, all in the same town and range, may be recorded on this certificate.**

A. Description of original monument and accessories and/or subsequent restoration:

- H-13 - South 1/4 corner Section 34, T18N, R11W, Pinora Twp., Lake Co., Mi.
- 1837 - John Hodgson, D.S., G.L.O.      1930 - George Johnson, County Surveyor
- #1 - 24" Elm N64°E 34 Links      In road survey measured 2638 feet from Section corner West, showed 24" culvert at this position. No accessories given.
- #2 - 7" Elm N18°W 14 Links
- 1989 - Robert L. Wetherell, LS 24624
- Found 5/8" rod on Township line in line with old fence line North. Culvert under corner. Closing corner 7.0 feet West. Certificate of Survey recorded in Liber 03, Page 297.

B. Description of corner evidence found and/or method applied in restoring or reestablishing corner:

H-13 - South 1/4 corner Section 34, T18N, R11W, Pinora Twp., Lake Co., Mi.


I was unable to recover the 5/8" rod I found in 1989 (due to road construction). I re-established the corner from 33 feet offset irons that I recovered from my 1989 survey recorded in Liber 03, Page 297 and a recovered accessory for the North 1/4 corner Section 3, (T17N, R11W) (7.0' West). Corner is 7 feet more or less South of centerline of East and West blacktop road. Condition of accessories are as follows: #1 Gone, #2 Gone.

C. Description of monument for corner and accessories established to perpetuate locating the position of the corner:

H-13 - South 1/4 corner Section 34, T18N, R11W, Pinora Twp., Lake Co., Mi.

I set a 3/4" x 24" re-bar with Lake County Brass Cap, and is accepted as a careful and faithful re-establishment of the position of the original corner.

14" Apple S73°W 50.10' (60d spike in S. side of tree)  
10" Elm S49°E 32.48' (60d spike in N.E. side of tree)  
8" Elm N12°E 109.85' (60d spike in E. side of tree)  
Brass Cap monument - West 7.00' (Closing 1/4 corner) (3/4" x 24" re-bar with Lake County Brass Cap)

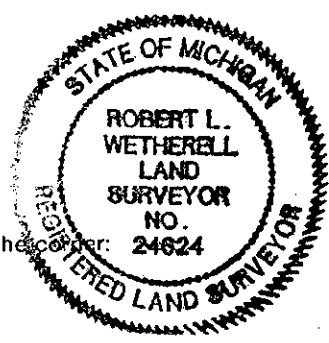

Signed by Robert L. Wetherell Date 10-26-94

Surveyor's Michigan License No. 24624 RATIFIED BY THE LAKE CO. PEER REVIEW GROUP  
IN ACCORDANCE WITH P.A. 345  
CHAIRMAN RLW  
DATE 10-25-94

FORM APPROVED BY MICHIGAN STATE BOARD OF LAND SURVEYORS, JAN. 28, 1971  
REVISED MAY 14, 1975  
REVISED JAN., 1983