

NOV 21 1997

COMMISSION

LAND CORNER RECORDATION CERTIFICATE
Filing Requirement of Act 74, Mich. P.A. 1970

RECORDED LAKE COUNTY, MI.

LIBER 004 PAGE 0053

SEP 12 10 32 AM '97


REGISTER OF DEEDS

For corners in

Table with columns: Lake (County), Located In: (18N, 11W), Corner Code # (I-3). Rows include Public Land Survey, Property Controlling in Section, and Miscellaneous Property in Sec.

4. Lot No. , Recorded Plat
5. Private Claims

Register of Deeds Stamp & File Number

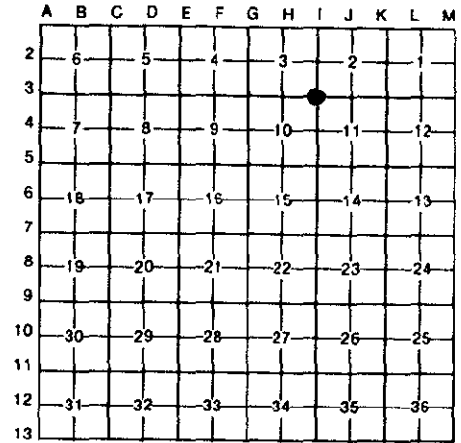

I, Robert L. Wetherell, in a field survey on May 15, 1997, do hereby certify that under requirements of P.A. 74, Michigan P.A. of 1970, the corner points mentioned in lines 1 and 2 above were in conformance with regulations and rules therefore as required in the current manual of survey instructions of the United States Department of the Interior, Bureau of Land Management or by a decree of a Court of Law and/or that the corner points mentioned in lines 3, 4 and 5 above were in conformance with the rules of the Michigan Board of Land Surveyors or by a Decree of a Court of Law; established, re-established, monumented, re-monumented, recovered, found as expressed below:

NOTE: Not more than 4 corners, all in the same town and range, may be recorded on this certificate.

A. Description of original monument and accessories and/or subsequent restoration:

I-3 -Section corner common to Sections 2, 3, 10 & 11, T18N, R11W, Lake Co., Mi.

- 1838 - John Hodgson, G.L.O.
#1 - 9" Beech S14°W 21 Links
#2 - 10" Beech N28°E 41 Links
Undated - George Johnson, Co. Sur.
1/2" x 1" x 3' Iron
#3 - 36" Pine Stump N63°E 27'
1972 - James Fraus, LS 17089
L.C.R.C. - Liber 02, Pg. 156
Found 2" Iron (Set 1/2" Iron)
#4 - Fence Post N58°W 42.0'
#5 - Stop sign N36°E 58.52'
#6 - P. Pole S45°W 49.31'
1988 - Robert L. Wetherell, LS 24624
#7 - 10" Cherry S6°E 51.27'
#8 - P. Pole N57°E 101.10'
#9 - 5" Pine: S74°W 133.86'

B. Description of corner evidence found and/or method applied in restoring or reestablishing corner:

I-3 -Section corner common to Sections 2, 3, 10 & 11, T18N, R11W, Lake Co., Mi.

I found 1/2" Re-bar 6 feet North of centerline of East and West road and in centerline of road to North. Directly below 1/2" Re-bar I found a 1/2" x 1" x 3' Iron with stones and old wood stake.

Condition of the accessories are as follows: #1 gone, #2 Gone, #3 Gone, #4 Found down, #5 Gone, #6 Fund Stump, #7 Found in good condition, #8 New Pole, #9 Found in good condition,

ATIFIED BY THE LAKE CO. PEER REVIEW GROUP
IN ACCORDANCE WITH P.A. 345
CHAIRMAN R.L.W.
DATE 8-27-97

Description of monument for corner and accessories established to perpetuate locating the position of the corner:


I-3 -Section corner common to Sections 2, 3, 10 & 11, T18N, R11W, Lake Co., Mi.

I replaced the 1/2" Re-bar with a 3/4" x 24" Re-bar and Lake County Brass Cap, and is accepted as a careful and faithful re-establishment of the position of the original corner.

- P. Pole N59°E 102.20' (P.K. in N. side)
5" S. Pine N74°W 133.73' (60d spike in S. side) #9
4" S. Pine N32°W 94.71' (60d spike in W. side)
4" R. Pine S47°W 65.63' (60d spike in W. side)
13" Tw. Cherry S4°E 51.26' (Found nail in E. side) #7

Wetherell by Robert L. Wetherell 24624

Date 8-27-97

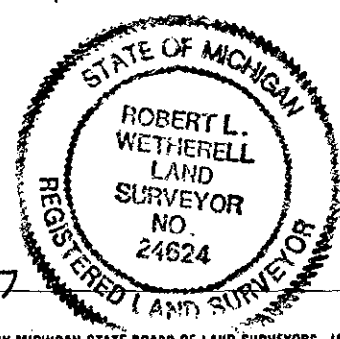

Surveyor's Michigan License No.