

NOV 15 1994

COMMISSION

LAND CORNER RECORDATION CERTIFICATE **IBER003** PAGE **0258**
Filing Requirement of Act 74, Mich. P.A. 1970

For corners in

Lake (County)	Located In:	Corner Code #
1. Public Land Survey	T 18N R 11W	I-13
	T R	
	T R	
	T R	
2. Property Controlling in Section	S T R	
	S T R	
3. Miscellaneous Property in Sec.	S T R	
	S T R	

REGISTER OF DEEDS
 Oct 27 3 24 PM '94
 RECORDED
 LAKE COUNTY, MI.

Register of Deeds Stamp & File Number

- 4. Lot No. _____, Recorded Plat _____
- 5. Private Claims _____

	A	B	C	D	E	F	G	H	I	J	K	L	M
2	6		5		4		3		2		1		
3													
4	7		8		9		10		11		12		
5													
6	18		17		16		15		14		13		
7													
8	19		20		21		22		23		24		
9													
10	30		29		28		27		26		25		
11													
12	31		32		33		34		35		36		
13													

I, Robert L. Wetherell, in a field survey on October 10, 1994, do hereby certify that under requirements of P.A. 74, Michigan P.A. of 1970, the corner points mentioned in lines 1 and 2 above were in conformance with regulations and rules therefore as required in the current manual of survey instructions of the United States Department of the Interior, Bureau of Land Management or by a decree of a Court of Law and/or that the corner points mentioned in lines 3, 4 and 5 above were in conformance with the rules of the Michigan Board of Land Surveyors or by a Decree of a Court of Law; established, re-established, monumented, re-monumented, recovered, found as expressed below:

NOTE: Not more than 4 corners, all in the same town and range, may be recorded on this certificate.

A. Description of original monument and accessories and/or subsequent restoration:

- I-13 - Section corner common to Sections 34 and 35, T18N, R11W, on township line, Pinora Twp., Lake Co., Mi.
 - 1837 - John Hodgson, D.S., G.L.O. #1 - 16" Sugar N10°W 18 Links #2 - 7" Ironwood N73°E 20 Links
 - 1975 - Clinton E. Cole, LS 17615 Found railroad spike at intersection of gravel roads.
 - 1989 - Robert L. Wetherell, LS 24624 Found railroad spike #3 - P. Pole S61°W 86.93' #4 - 22" Maple N76°W 131.51' #5 - P. Pole S60°E 98.31'

B. Description of corner evidence found and/or method applied in restoring or reestablishing corner:

I-13 - Section corner common to Sections 34 and 35, T18N, R11W, on township line, Pinora Twp., Lake Co., Mi.


I found a railroad spike at intersection of roads. Railroad spike probably from surveyor Ed Benkert, this was a common monument used by Mr. Benkert. Benkert divided the S.W.1/4-S.W.1/4, Sec. 35, sometime in the Early 70's. No map on record. This position is in harmony with 1/16 line fences both East and West. Condition of accessories are as follows: #1 Gone, #2 Gone, #3 Found in good condition, #4 Found in good condition, #5 Found in good condition.

C. Description of monument for corner and accessories established to perpetuate locating the position of the corner:

I-13 - Section corner common to Sections 34 and 35, T18N, R11W, on township line, Pinora Twp., Lake Co., Mi.

I replaced the railroad spike with a 3/4" x 24" re-bar with Lake County Brass Cap in a monument box, and is accepted as a careful and faithful re-establishment of the position of the original corner.

- Capped Iron N40°W 47.60' (Gordon Bonney)
- Power Pole S61°W 86.93' (60d spike in S.E. side) (#3)
- 10"-12" Twin Maple S62°E 80.34' (60d spike in S.E. side of tree)
- 22" Maple N76°W 131.51' (60d spike in S. side of tree) (#4)
- P. Pole S60°E 98.31' (60d spike in N. side) (#5)
- Brass Capped Monument - West 15.18' (Sec. cor. for Sec's. 2 & 3, T17N, R11W)
- (3/4" x 24" re-bar with Lake County Brass Cap)

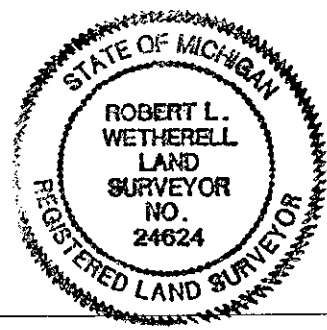

Signed by Robert L. Wetherell Date 10-26-94
 24624