

**SURVEY & REMONUMENTATION**

AUG 31 1999

SECTION

**LAND CORNER RECORDATION CERTIFICATE**

FILING REQUIREMENT OF ACT 74, Mich. P.A. 1970

RECORDED  
LAKE COUNTY, MI.  
LIBER 004 PAGE 0191

JUL 23 3 03 PM '99

*Deborah H. Richard*  
REGISTER OF DEEDS

Register of Deeds Stamp & File Number

For corners in Lake	Located in:	Corner Code#
1. Public Land Survey	T 18N R 11W	K-2
	T R	
	T R	
	T R	
2. Property Controlling in Section	S T R	
	S T R	
3. Miscellaneous Property in Sec.	S T R	
	S T R	
4. Lot No. Recorded Plat		
5. Private Claims		

	A	B	C	D	E	F	G	H	I	J	K	L	M
1													
2	6	5	4	3	2	1							
3													
4	7	8	9	10	11	12							
5													
6	18	17	16	15	14	13							
7													
8	19	20	21	22	23	24							
9													
10	30	29	28	27	26	25							
11													
12	31	32	33	34	35	36							
13													

I, Robert L. Wetherell, in a field survey on June 2, 1999, do hereby certify that under requirements of P.A. 74, Michigan P.A. of 1970, the corner points mentioned in lines 1 and 2 above were in conformance with regulations and rules therefore as required in the current manual of survey instructions of the United States Department of the Interior, Bureau of Land Management or by decree of a Court of Law and/or that the corner points mentioned in lines 3, 4, and 5 above were in conformance with the rules of the Michigan Board of Land Surveyors or by a Decree Of a Court of Law; established, re-established, monumented, re-monumented, recovered, found as expressed below:

**K-2 - 1/4 Corner common to Sections 1 & 2, T18N, R11W**

**A. Description of original monument and accessories and/or subsequent restoration:**

1838 - J. Hodgson, G.L.O.  
#1 - 7" Beech N26°E 22 Links  
#2 - 6" Maple S57°W 28 Links

1974 - C. Cole, LS 17615  
Surveyed and divided the SW 1/4-SW 1/4, Sec. 1.  
Did not set 1/4 corner.

1993 - R.L. Wetherell, LS 24624  
L.C.R.C. - L. 03, Pg. 111  
Set 1/2" Capped Iron on line between Section corner according to Cole's information.  
#3 - 8" R. Pine S67°W 54.69'  
#4 - Cherry Clump N18°W 31.19'  
#5 - 12" W. Pine N43°E 63.58'  
#6 - Maple Clump S27°E 53.07'

1973 - C. Cole, LS 17615  
Shows computed position on line between NW cor. Sec. 1 & SW cor. Sec. 1  
Distance to NW 2685.28  
Distance to SW 2587.48

**B. Description of corner evidence found and/or method applied in restoring or reestablishing corner:**

I found the 1/2" Capped Iron I set in 1993 on the West edge of a North and South dirt road. Corner is opposite old large corner post to the East. I found Cole's 1/16 corner to the South, which is in an old fence line to the East and West. Corner is 47.25 feet South of a G.L.O. proportionate position. I believe Cole used the S. 1/16 line fences to position this corner. This position is also supported by the 1938 aerial photographs.


Condition of the accessories are as follows: #1 Gone, #2 Gone, #3 Found in good condition, #4 Found in good condition, #5 Found in condition, #6 Found in good condition.

**C. Description of monument for corner and accessories established to perpetuate locating the position of the corner:**

I replaced the 1/2" Capped Iron with a 3/4" x 24" re-bar with Lake County Remon Cap, and is accepted as a careful and faithful re-establishment of the position of the original corner.

9" R. Pine S67°W 34.37' (60d spike in N. side) #3  
Cherry Clump N18°W 31.16' (60d spike in W. side) #4  
14" W. Pine N43°E 63.58' (60d spike in S. side) #5  
Maple Clump S27°E 53.01' (60d spike in E. side) #6

RATIFIED BY THE LAKE CO. REEPL REVIEW GROUP  
IN ACCORDANCE WITH P.A. 345  
CHAIRMAN *EW*  
DATE 7-20-99

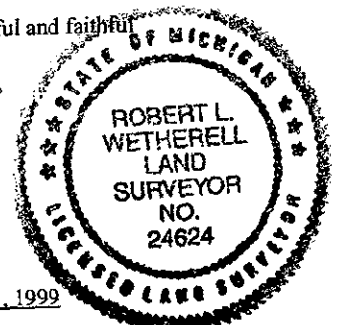

Signed by Robert L. Wetherell  
Surveyor's Michigan License No. 24624

Date July 21, 1999