

SURVEY & REMONUMENTATION

AUG 31 1999

LAND CORNER RECORDATION CERTIFICATE

FILING REQUIREMENT OF ACT 74, Mich. P.A. 1970

RECORDED
LAKE COUNTY, MI.

SECTION

LIBER 004 PAGE 0192
JUL 23 3 03 PM '99

For corners in Lake	Located in:	Corner Code#
1. Public Land Survey	T 18N	R 11W K-3
	T	R
	T	R
	T	R
2. Property Controlling in Section	T	R
	S T	R
3. Miscellaneous Property in Sec.	S T	R
	S T	R
4. Lot No. _____ Recorded Plat		
5. Private Claims		

William H. Dickson
REGISTER OF DEEDS

Register of Deeds Stamp & File Number

	A	B	C	D	E	F	G	H	I	J	K	L	M
1													
2	6	5	4	3	2	1							
3													
4	7	8	9	10	11	12							
5													
6	18	17	16	15	14	13							
7													
8	19	20	21	22	23	24							
9													
10	30	29	28	27	26	25							
11													
12	31	32	33	34	35	36							
13													

I, Robert L. Wetherell, in a field survey on June 1, 1999, do hereby certify that under requirements of P.A. 74, Michigan P.A. of 1970, the corner points mentioned in lines 1 and 2 above were in conformance with regulations and rules therefore as required in the current manual of survey instructions of the United States Department of the Interior, Bureau of Land Management or by decree of a Court of Law and/or that the corner points mentioned in lines 3, 4, and 5 above were in conformance with the rules of the Michigan Board of Land Surveyors or by a Decree Of a Court of Law; established, re-established, monumented, re-monumented, recovered, found as expressed below:

K-3 - Section corner common to Sections 1, 2, 11 & 12, T18N, R11W

A. Description of original monument and accessories and/or subsequent restoration:

1838 - J. Hodgson, G.L.O.

- #1 - 12" Beech N36°E 16 Links
- #2 - 11" Beech S42°W 48 Links

1929 - G. Johnson, Co. Sur.

- Monument not given
- #3 - 12" B. Oak S64°45'W 61'
- #4 - 24" P. Stump N25°E 41'
- #5 - N.W. Cor. School House S51°E 95'

1973 - C. Cole, LS 17615

- L.C.R.C. - L. 02, Pg. 175
- Found Angle Iron - raised to surface with 1/2" rod
- #6 - 16" S. Pine S26°E 51.78'
- #7 - 26" Maple S66°W 61.24'
- #8 - P. Pole N44°W 78.12'

1987 - C. Cole, LS 17615

- Survey of SW 1/4 of NW 1/4, Sec. 12,
- Shows distance of 2637.64' to South 1/4 cor.
- No accessories or monument given.
- (Lakestate File No. 4747-87)

1989 - R.L. Wetherell, LS 24624

- Survey recorded L. 03, Pg. 181
- #7 - 30" Maple S66°W 61.20'
- #9 - 18" R. Pine S25°E 78.51'
- #8 - P. Pole N42°W 78.03'

B. Description of corner evidence found and/or method applied in restoring or reestablishing corner:

I found a 1/2" re-bar at surface of road. At a depth of 3.5' more or less I found a 1" angle iron badly decomposed. Corner is in the centerline of roads East, West, North and South. Measured 2637.52 feet South to 1/4 corner.


Condition of the accessories are as follows: #1 Gone, #2 Gone, #3 Gone, #4 Gone, #5 Gone, #6 Gone, #7 Found in good condition, #8 Found in good condition, #9 Found in good condition.

C. Description of monument for corner and accessories established to perpetuate locating the position of the corner:

I replaced the 1/2" iron with a 3/4" x 24" re-bar with Lake Co. Remon Cap (directly over old angle iron), and is accepted as a careful and faithful re-establishment of the position of the original corner.

- 12" W. Oak S26°W 86.70' (60d spike in E. side)
- 30" Maple S66°W 61.23' (60d spike in N. side) #7
- 18" R. Pine S25°W 78.46' (60d spike in S.E. side) #9
- P. Pole N42°W 78.03' (found nail & tag #1237)

RATIFIED BY THE LAKE COUNTY REVIEW GROUP
IN ACCORDANCE WITH P.A. 345
CHAIRMAN *R&W*
DATE *7-20-99*

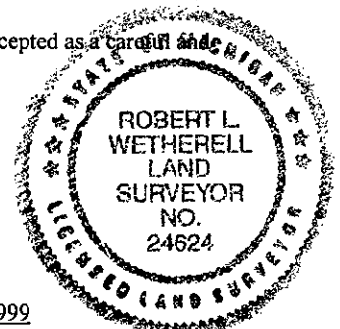

Signed by *Robert L. Wetherell*
Surveyor's Michigan License No. 24624

Date July 21, 1999