

**SURVEY & REMONUMENTATION**

**AUG 31 1999**

**LAND CORNER RECORDATION CERTIFICATE**

FILING REQUIREMENT OF ACT 74, Mich. P.A. 1970

RECORDED  
LAKE COUNTY, MI.

**SECTION**

LIBER 004 PAGE 0193  
JUL 23 3 03 PM '99

For corners in Lake	Located in:	Corner Code#
1. Public Land Survey	T 18N	R11W K-4
	T	R
	T	R
	T	R
2. Property Controlling in Section	S T	R
	S T	R
3. Miscellaneous Property in Sec.	S T	R
	S T	R
4. Lot No. _____ Recorded Plat		
5. Private Claims		

*Christina A. DeLeon*  
REGISTER OF DEEDS

Register of Deeds Stamp & File Number

	A	B	C	D	E	F	G	H	I	J	K	L	M
1													
2	6	5	4	3	2	1							
3													
4	7	8	9	10	11	12							
5													
6	18	17	16	15	14	13							
7													
8	19	20	21	22	23	24							
9													
10	30	29	28	27	26	25							
11													
12	31	32	33	34	35	36							
13													

I, Robert L. Wetherell, in a field survey on June 1, 1999, do hereby certify that under requirements of P.A. 74, Michigan P.A. of 1970, the corner points mentioned in lines 1 and 2 above were in conformance with regulations and rules therefore as required in the current manual of survey instructions of the United States Department of the Interior, Bureau of Land Management or by decree of a Court of Law and/or that the corner points mentioned in lines 3, 4, and 5 above were in conformance with the rules of the Michigan Board of Land Surveyors or by a Decree Of a Court of Law; established, re-established, monumented, re-monumented, recovered, found as expressed below:

**K-4 - 1/4 Corner common to Sections 11 & 12, T18N, R11W**

**A. Description of original monument and accessories and/or subsequent restoration:**

**1838 - J. Hodgson, G.L.O.**

#1 - 7" Beech N29°E 21 Links  
#2 - 10" Maple S81°W 34 Links

**1928 - G.H. Johnson, Co. Sur.**

Set 1/4 post N1°30'E 2640' from Sec. Cor.  
#3 - Old Brt. Pine Stump (10") S67°W 66.7'  
#4 - R. Cherry S32°15'E 52.2'

**1987 - C. Cole, LS 17615**

Set right of way iron 33' East  
Showed distance North 2637.64' to Section corner.  
#5 - 7" J. Pine S68°E 44.40'  
#6 - 8" R. Pine S58°W 52.31'  
#7 - 10" R. Pine N61°W 41.00'

**1989 - D. Wood, LS 24625**

L.C.R.C. - L. 03, Pg. 101  
Found 1/2" capped iron (marked LS 17615)  
#8 - 1/2" Rod AZ 90° 33.00'  
#5 - 8" Pine AZ 115° 44.44'  
#7 - 12" Pine AZ 290° 40.97'  
#9 - 10" Pine AZ 235° 43.06'

**B. Description of corner evidence found and/or method applied in restoring or reestablishing corner:**

I found a 1/2" capped iron (marked LS 17615) 1 foot more or less East of centerline of North and South road. Corner fits well with Johnson's old burnt pine stump. I presume that is how Cole set the corner. I measured 2637.52 feet North to Section corner and 2640.37 feet South to Sec. corner.


Condition of the accessories are as follows: #1 Gone #2 Gone, #3 Found in good condition (with scribing) #4 Gone, #5 Found in good condition, #6 Found in good condition, #7 Found in good condition, #8 Found in good condition, #9 Found in good condition.

**C. Description of monument for corner and accessories established to perpetuate locating the position of the corner:**

I replaced the 1/2" Capped Iron with a 3/4" x 24" re-bar with Lake County Remon Cap, and is accepted as a careful and faithful re-establishment of the position of the original corner.

7" J. Pine S64°E 44.37' (60d spike in S. side) #5  
9" R. Pine S55°W 52.32' (60d spike in N. side) #6  
14" R. Pine N63°W 41.05' (60d spike in S. side) #7  
30" R. Oak N17°E 119.10' (60d spike W. side)

RATIFIED BY THE LAKE CO. PEER REVIEW GROUP  
IN ACCORDANCE WITH P.A. 345  
CHAIRMAN *R&W*  
DATE 7-20-99

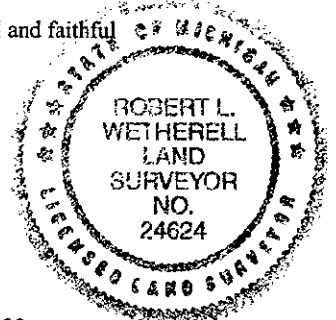

Signed by Robert L. Wetherell

Date July 21, 1999

Surveyor's Michigan License No. 24624