

**SURVEY & REMONUMENTATION**

**AUG 31 1999**

**LAND CORNER RECORDATION CERTIFICATE**

FILING REQUIREMENT OF ACT 74, Mich. P.A. 1970

RECORDED  
LAKE COUNTY, MI.  
LIBER 004 PAGE 0194

JUL 23 3 03 PM '99

*Spencer H. Deane*  
REGISTER OF DEEDS

**SECTION**

For corners in Lake	Located in:	Corner Code#
1. Public Land Survey	T 18N	R 11W K-5
	T	R
	T	R
	T	R
2. Property Controlling in Section	S T	R
	S T	R
3. Miscellaneous Property in Sec.	S T	R
	S T	R
4. Lot No. _____ Recorded Plat _____		
5. Private Claims _____		

Register of Deeds Stamp & File Number

	A	B	C	D	E	F	G	H	I	J	K	L	M
1													
2	6	5	4	3	2	1							
3													
4	7	8	9	10	11	12							
5													
6	18	17	16	15	14	13							
7													
8	19	20	21	22	23	24							
9													
10	30	29	28	27	26	25							
11													
12	31	32	33	34	35	36							
13													

I, Robert L. Wetherell, in a field survey on June 2, 1999, do hereby certify that under requirements of P.A. 74, Michigan P.A. of 1970, the corner points mentioned in lines 1 and 2 above were in conformance with regulations and rules therefore as required in the current manual of survey instructions of the United States Department of the Interior, Bureau of Land Management or by decree of a Court of Law and/or that the corner points mentioned in lines 3, 4, and 5 above were in conformance with the rules of the Michigan Board of Land Surveyors or by a Decree Of a Court of Law; established, re-established, monumented, re-monumented, recovered, found as expressed below:

**K-5 - Section corner common to Sections 11, 12, 13 & 14, T18N, R11W**

**A. Description of original monument and accessories and/or subsequent restoration:**

**1838 - J. Hodgson, G.L.O.**  
#1 - 16" Pine N34°E 17 Links  
#2 - 10" Birch S43°W 31 Links

**1954 - G. Blass, LS 5489**  
Iron Bar  
#3 - 12" Elm Clump S58°W 56.15'  
#4 - 14" Tamarack N52°E 88.17'  
#5 - (No specifics given)  
(Showed tree symbol)  
N35°E 63.20'

**1989 - R.L. Wetherell, LS 24624**  
Found Iron Bar  
#6 - P. Pole S50°E 49.83'  
#7 - 6" Elm S44°W 44.45'  
#8 - 10" J. Pine N48°W 55.83'

**1928 - G. H. Johnson, Co. Sur.**  
Used for road construction  
No monument or accessories given.

**B. Description of corner evidence found and/or method applied in restoring of reestablishing corner:**

I found an old hub with shaft, 30" long, in the center of road West and 1.5 feet more or less west of road North and South.


Condition of the accessories are as follows: #1 Gone, #2 Gone, #3 Gone, #4 Gone, #5 Found dead Maple (with nail at 63.3 feet), #6 Found in good condition, #7 Found in good condition, #8 Found in good condition.

**C. Description of monument for corner and accessories established to perpetuate locating the position of the corner:**

I broke the shaft off the hub and set a 3/4" x 24" re-bar with Lake County Remon Cap over top of the hub and is accepted as a careful and faithful re-establishment of the position of the original corner.

6" Elm S45°W 44.39' (60d spike in S.E. side) 37  
P. Pole S50°E 49.85' (60d spike in N. side) #6  
5" W. Pine N53°W 55.55' (60d spike in S. side)  
14" Maple N37°E 72.41' (60d spike in W. side)

RATIFIED BY THE LAKE CO. PEER REVIEW GROUP  
IN ACCORDANCE WITH P.A. 345  
CHAIRMAN *R.W.*  
DATE 7-20-99

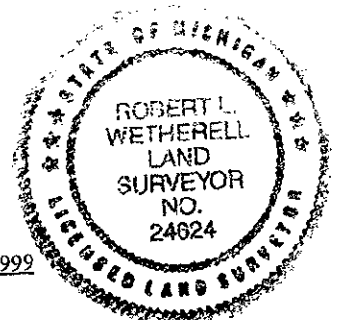

Signed by Robert L. Wetherell

Date July 21, 1999

Surveyor's Michigan License No. 24624