

SECTION

LAND CORNER RECORDATION CERTIFICATE
Filing Requirement of Act 74, Mich. P.A. 1970

For corners in
Lake

Located in:	Corner Code #
T ^{18N} R ^{11W}	K-9
T R	
T R	
T R	
T R	
S T R	
S T R	
S T R	
S T R	

REGISTER OF DEEDS
 Oct 29 4 40 PM '98
 REGISTERED
 LAKE COUNTY, MI.

Register of Deeds Stamp & File Number

- 1. Public Land Survey
- 2. Property Controlling in Section
- 3. Miscellaneous Property in Sec.

- 4. Lot No. _____, Recorded Plat _____
- 5. Private Claims _____

	A	B	C	D	E	F	G	H	I	J	K	L	M
1													
2	6		5		4		3		2		1		
3													
4	7		8		9		10		11		12		
5													
6	10		17		16		15		14		13		
7													
8	19		20		21		22		23		24		
9													
10	30		29		28		27		26		25		
11													
12	31		32		33		34		35		36		
13													

I, Robert L. Wetherell, in a field survey on March 25, 1998 do hereby state that under requirements of P.A. 74, Michigan P.A. of 1970, the corner points mentioned in lines 1 and 2 above were in conformance with regulations and rules therefore as required in the current manual of survey instructions of the United States Department of the Interior, Bureau of Land Management or by a decree of a Court of Law and /or that the corner points mentioned in lines 3, 4 and 5 above were in conformance with the rules of the Michigan Board of Land Surveyors or by a Decree of a Court of Law; established, re-established, monumented, recovered, found as expressed below:

NOTE: Not more than 2 corners, all in the same town and range, may be recorded on this certificate.

A. Description of original monument and accessories and/or subsequent restoration:

- K-9 - Section corner common to Sections 23, 24, 25 & 26, T18N, R11W, Pinora Twp., Lake Co., Mi.
 - 1838 - J. Hodgson, G.L.O. .
 - 1924 - G. Johnson, County Surveyor
 - #1 - 16" Beech N17°W 22 Links
 - Staking for road survey shows 2627 feet to 1/4 corner South. Large Stone & Pipe.
 - #2 - 12" Beech S33°E 13 Links
 - #3 - 6" Apple S71°W 128'
 - Shows fence line to West and centerline of road to East.

(SEE OVER FOR CONTINUATION OF "A")

RATIFIED BY THE LAKE CO. PEER REVIEW GROUP
 IN ACCORDANCE WITH P.A. 345
 CHAIRMAN R.L.W.
 DATE 10-27-98

B. Description of corner evidence found and/or method applied in restoring or reestablishing corner:

- K-9 - Section corner common to Sections 23, 24, 25 & 26, T18N, R11W, Pinora Twp., Lake Co., Mi.

I found 1/2" capped re-bar in centerline of roads North, South and East and in line with fence to West. I measured 2623.62 feet to 1/4 corner South. I measured 2637.34' North to the 1/4 corner.

Condition of the accessories are as follows: #1 Gone, #2 Gone, #3 Gone, #4 Found in good condition, #5 Found in good condition, #6 Found in good condition, #7 Found in good condition.

C. Description of monument for corner and accessories established to perpetuate locating the position of the corner:


- K-9 - Section corner common to Sections 23, 24, 25 & 26, T18N, R11W, Pinora Twp., Lake Co., Mi.

I replaced the 1/2" Capped Iron with a 3/4" x 24" re-bar with Lake County Brass Cap, and is accepted as a careful and faithful re-establishment of the position of the original corner.

Center of Michigan Wisconsin Storage Well N51°E 177.3' - #4
 Northwest corner building foundation S18°E 172.60' - #5
 16" J. Pine S81°W 44.25' (60d spike in S. side) #6
 13" J. Pine N27°W 73.98' (60d spike in S.W. side) #7

Signed by Robert L. Wetherell
 Surveyor's Michigan License No. 24624

Date 10-29-98

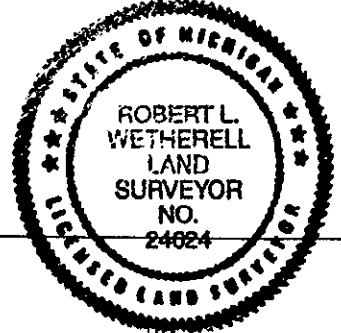

210 2 8 1833

SECTION

LIBER004 PAGE0181

CONTINUATION OF "A" - DESCRIPTION OF ORIGINAL MONUMENT AND ACCESSORIES AND/OR SUBSEQUENT RESTORATION:

1981 - John Nelson, LS 21273

L.C.R.C. - Liber 02, Pg. 399.

Found PK Nail - replaced with

5/8" iron. In line with fence to West.

#4 - Mi. Wi. Storage Well AZ 50° 177.30'

#5 - NW cor. Bldg. Fnd. AS 159° 172.60'

#6 - 12" J. Pine AZ 260° 44.26'

#7 - 10" J. Pine AZ 333° 73.98'

1993 - R.L. Wetherell, LS 24624

L.C.R.C. - Liber. 03 Pg. 173

Set 1/2" re-bar from Nelson's

accessories of 1981.

#5 - NW corner bldg. Fnd. S20oE 172.60'

#6 - 16" J. Pine S80°W 44.26'

#7 - 12" J. Pine N27°W 73.98'

#4 - Well N50°E 177.3'