

SURVEY & REMONUMENTATION

AUG 31 1999

LAND CORNER RECORDATION CERTIFICATE

FILING REQUIREMENT OF ACT 74, Mich. P.A. 1970

RECORDED
LAKE COUNTY, MI.
LIBER 004 PAGE 0195

SECTION

| For corners in Lake | Located in: | Corner Code# |
|---------------------------------------|-------------|--------------|
| 1. Public Land Survey | T 18N | R 11W L-5 |
| | T | R |
| | T | R |
| | T | R |
| 2. Property Controlling in Section | S T | R |
| | S T | R |
| 3. Miscellaneous Property in Sec. | S T | R |
| | S T | R |
| 4. Lot No. _____ Recorded Plat | | |
| 5. Private Claims | | |

Jul 23 3 03 PM '99

Archie H. Beckwith
REGISTER OF DEEDS

Register of Deeds Stamp & File Number

I, Robert L. Wetherell, in a field survey on June 3, 1999, do hereby certify that under requirements of P.A. 74, Michigan P.A. of 1970, the corner points mentioned in lines 1 and 2 above were in conformance with regulations and rules therefore as required in the current manual of survey instructions of the United States Department of the Interior, Bureau of Land Management or by decree of a Court of Law and/or that the corner points mentioned in lines 3, 4, and 5 above were in conformance with the rules of the Michigan Board of Land Surveyors or by a Decree Of a Court of Law; established, re-established, monumented, re-monumented, recovered, found as expressed below:

| | A | B | C | D | E | F | G | H | I | J | K | L | M |
|----|----|----|----|----|----|----|---|---|---|---|---|---|---|
| 1 | | | | | | | | | | | | | |
| 2 | 6 | 5 | 4 | 3 | 2 | 1 | | | | | | | |
| 3 | | | | | | | | | | | | | |
| 4 | 7 | 8 | 9 | 10 | 11 | 12 | | | | | | | |
| 5 | | | | | | | | | | | | | |
| 6 | 18 | 17 | 16 | 15 | 14 | 13 | | | | | | | |
| 7 | | | | | | | | | | | | | |
| 8 | 19 | 20 | 21 | 22 | 23 | 24 | | | | | | | |
| 9 | | | | | | | | | | | | | |
| 10 | 30 | 29 | 28 | 27 | 26 | 25 | | | | | | | |
| 11 | | | | | | | | | | | | | |
| 12 | 31 | 32 | 33 | 34 | 35 | 36 | | | | | | | |
| 13 | | | | | | | | | | | | | |

L-5 - 1/4 Corner common to Sections 12 & 13, T18N, R11W.

A. Description of original monument and accessories and/or subsequent restoration:

1838 - Hodgson, G.L.O.

- #1 - 7" Hemlock N31°W 13 Links
- #2 - 16" Hemlock S34°E 25 Links

1980 - R.L. Wetherell, LS 24624

- Set 1/2" Iron Rod in center of old road bed and in line with old fence to the South.
- #3 - 8" Cedar S24°W 24.70'
- #4 - 8" Maple N50°E 17.11'
- #5 - 12" Maple N10°W 22.40'

B. Description of corner evidence found and/or method applied in restoring of reestablishing corner:

I found the 1/2" iron rod I set in 1980. I measured 2646.75 feet East to the Section corner and 2626.70 feet West to the Section corner.


Condition of the accessories are as follows: #1 Gone, #2 Gone, #3 Found in good condition, #4 Found in good condition, #5 Found in good condition.

C. Description of monument for corner and accessories established to perpetuate locating the position of the corner:

I replaced the 1/2" rod with a 3/4" x 24" re-bar with Lake County Remon Cap, and is accepted as a careful and faithful re-establishment of the position of the original corner.

- 16" Tw. Cherry S47°W 54.05' (60d spike in N. side)
- 6" Maple N55°W 11.25' (60d spike in N.E. side)
- 9" Cedar S28°W 24.65' (Found nail in E. side) #3
- 8" Maple N50°E 17.22' (Found nail in N. side) #4
- 14" Maple N10°W 22.44' (60d spike in W. side) #5

RATIFIED BY THE LAKE CO. PEER REVIEW GROUP
IN ACCORDANCE WITH P.A. 345
CHAIRMAN *ELW*
DATE 7-20-99

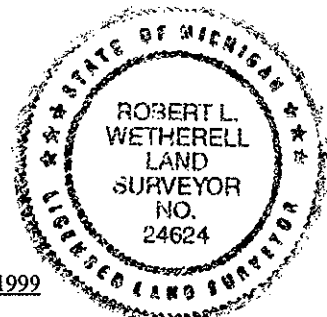

Signed by Robert L. Wetherell

Date July 21, 1999

Surveyor's Michigan License No. 24624