DEC 2 9 1998

SECTION

LAND CORNER RECORDATION CERTIFICATE
Filing Requirement of Act 74, Mich. P.A. 1970

LIBER 004 PAGE 0184

RECORDED LAKE COUNTY, MI.
OCT 29 4 40 PM '98
Jeanine K. Richard
REGISTER OF DEEDS

Register of Deeds Stamp & File Number

For corners in Lake (County)

	Located In:		Corner Code #
	18N	11W	L-9
1. Public Land Survey	T___ R___		_____
	T___ R___		_____
	T___ R___		_____
	T___ R___		_____
2. Property Controlling	S___ T___ R___		_____
in Section	S___ T___ R___		_____
3. Miscellaneous	S___ T___ R___		_____
Property in Sec.	S___ T___ R___		_____

4. Lot No. _____ , Recorded Plat _____
5. Private Claims _____

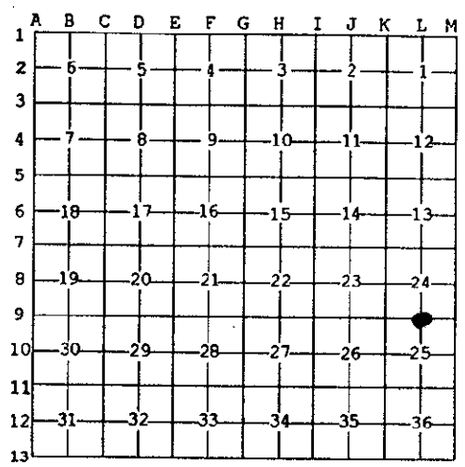

Robert L. Wetherell Oct. 19 98

I, _____, in a field survey on _____, 19 ____ do hereby state that under requirements of P.A. 74, Michigan P.A. of 1970, the corner points mentioned in lines 1 and 2 above were in conformance with regulations and rules therefore as required in the current manual of survey instructions of the United States Department of the Interior, Bureau of Land Management or by a decree of a Court of Law and /or that the corner points mentioned in lines 3, 4 and 5 above were in conformance with the rules of the Michigan Board of Land Surveyors or by a Decree of a Court of Law; established, re-established, monumented, recovered, found as expressed below:

NOTE: **Not more than 2 corners, all in the same town and range, may be recorded on this certificate.**

A. Description of original monument and accessories and/or subsequent restoration:

L-9 - 1/4 Corner common to Sections 24 & 25, T18N, R11W, Lake Co., Mi.

1838 - J. Hodgson, G.L.O.
#1 - 8" Beech N55°W 21 Links
#2 - 6" Lynn S64°E 9 Links

1981 - John Nelson, LS 21273
L.C.R.C. - Liber 02, Pg. 410
Found 5/8" Capped Iron (LS 13603)
#3 - 24" Maple AZ 24° 164.60'
#4 - 4" Elm AZ 173° 27.80'
#5 - Fence Post AZ 228° 39.95'
#6 - Power Pole AZ 307° 97.20'

1994 - Robert L. Wetherell, LS 24624
#7 - Power Pole N52°W 96.87'
#8 - 7" W. Pine S75°W 66.21'
#9 - Power Pole N84°E 285.54'

RATIFIED BY THE LAKE CO. PEER REVIEW GROUP IN ACCORDANCE WITH P.A. 345
CHAIRMAN C.X.W.
DATE 10-27-98

B. Description of corner evidence found and/or method applied in restoring or reestablishing corner:

L-9 - 1/4 Corner common to Sections 24 & 25, T18N, R11W, Lake Co., Mi.

I found 5/8" rebar at the surface of East and West road. Below the 5/8" rod I found old railroad rail. Corner is in centerline of East and West road and in line with old fence berm to the South. Position fits well with 1/16 line fences to the East and West.

Condition of the accessories are as follows: #1 Gone, #2 Gone, #3 gone, #4 Found Dead, #5 Found Leaning #6, Gone, #7 Found in good condition, #8 Found in good condition, #9 Found in good condition.

C. Description of monument for corner and accessories established to perpetuate locating the position of the corner:

L-9 - 1/4 Corner common to Sections 24 & 25, T18N, R11W, Lake Co., Mi.

I set a 3/4" x 14" rebar with Lake County Brass Cap directly over the railroad rail, and is accepted as a careful and faithful re-establishment of the position of the original corner.

Power Pole N52°W 96.87' (60d spike in N.E. side) #7
7" W. Pine S75°W 66.21' (60d spike in N. side) #8
Power Pole N84°E 285.54' (60d spike in S. side) #9
3/4" rebar with brass cap (S.W. cor. Sec. 24) - West 2689.08'

Signed by Robert L. Wetherell Date 10-29-98
Surveyor's Michigan License No. 24624

STATE OF MICHIGAN
ROBERT L. WETHERELL
LAND SURVEYOR
NO. 24624
LICENSED LAND SURVEYOR

FORM APPROVED BY MICHIGAN STATE BOARD OF PROFESSIONAL SURVEYORS, JAN. 28, 1971
REVISED MAY 14, 1975
REVISED JAN., 1983
REVISED OCT., 1995