

SURVEY & REMONUMENTATION

AUG 31 1999

LAND CORNER RECORDATION CERTIFICATE

FILING REQUIREMENT OF ACT 74, Mich. P.A. 1970

SECTION

For corners in Lake	Located in:	Corner Code#
1. Public Land Survey	T 18N R 11W	M-1
	T 19N R 11W	M-13
	T R	
	T R	
2. Property Controlling in Section	S T R	
	S T R	
3. Miscellaneous Property in Sec.	S T R	
	S T R	
4. Lot No. _____ Recorded Plat _____		
5. Private Claims _____		

RECORDED
LAKE COUNTY, MI.
LIBER 004, PAGE 0220
JUL 23 3 07 PM '99

Shirley M. Dechard
REGISTER OF DEEDS

Register of Deeds Stamp & File Number

	A	B	C	D	E	F	G	H	I	J	K	L	M
1													
2	6	5	4	3	2	1							
3													
4	7	8	9	10	11	12							
5													
6	18	17	16	15	14	13							
7													
8	19	20	21	22	23	24							
9													
10	30	29	28	27	26	25							
11													
12	31	32	33	34	35	36							
13													

I, Robert L. Wetherell, in a field survey on June 1, 1999, do hereby certify that under requirements of P.A. 74, Michigan P.A. of 1970, the corner points mentioned in lines 1 and 2 above were in conformance with regulations and rules therefore as required in the current manual of survey instructions of the United States Department of the Interior, Bureau of Land Management or by decree of a Court of Law and/or that the corner points mentioned in lines 3, 4, and 5 above were in conformance with the rules of the Michigan Board of Land Surveyors or by a Decree Of a Court of Law; established, re-established, monumented, re-monumented, recovered, found as expressed below:

M-1 - N.E. Corner Section 1, T18N, R11W
M-13 - S.E. Corner Section 36, T19N, R11W

A. Description of original monument and accessories and/or subsequent restoration:

1837 - J. Hodgson, G.L.O.
#1 - 16" Sugar S78°W 52 Links
#2 - 16" Sugar N25°E 10 Links

1891 - 1904 - A. Temple/F. Trumbull
Remonumentation of T19N, R10W
Set 3" Clay Tiles

Undated - G.H. Johnson, Co. Sur.
"Stone below surface"
#3 - 18" Elm S73°E 107 Links
#4 - 14" Elm S51°W 41 Links

(SEE OVER FOR CONTINUATION OF "A")

B. Description of corner evidence found and/or method applied in restoring of reestablishing corner:

I found McClung's Osceola County Monument in the intersection of roads North, South, East and West.


Condition of the accessories are as follows: #1 Gone, #2 Gone, #3 Gone, #4 Gone, #5 Gone, #6 Gone, #7 Found in good condition, #8 Found Stump, #9 Found in good condition, #10 Found in good condition, #11 Gone, #12 Found in good condition, #13 Found in good condition, #14 Found in good condition, #15 Found in good condition.

C. Description of monument for corner and accessories established to perpetuate locating the position of the corner:

I accepted the Osceola County Monument (1-1/2" Pipe with Osceola County Remon Cap) as a substantial marker for the corner and as a careful and faithful re-establishment of the position of the original corner.

P. Pole N52°E 74.55' (Found spike in S.E. side) #7
6" W. Pine S76°E 164.77' (60d spike in N. side) #12
6" Elm N5°W 103.49' (60d spike in W. side) #13
Treated Post S40°E 46.00' (60d spike in N.E. side) #9
12" W. Pine S28°W 116.15' (Center of Tree) #14

RATIFIED BY THE LAKE CO. PEER REVIEW GROUP
IN ACCORDANCE WITH P.A. 345
CHAIRMAN RJW
DATE 7-20-99

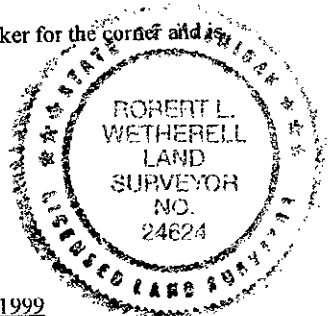

Signed by Robert L. Wetherell

Date July 21, 1999

Surveyor's Michigan License No. 24624

**SURVEY &
REMONUMENTATION**

AUG 31 1999

SECTION

LIBER004 PAGE0221

CONTINUATION OF DESCRIPTION OF ORIGINAL MONUMENT AND ACCESSORIES AND/OR SUBSEQUENT RESTORATION:

1920 m/l - Osceola Co. Survey Records

Rod

#5 - 8" Elm N.W. 59.6'

#6 - Rock S.W. 38.5'

1959 - G. Blass, LS 5489

1/2" x 36" Rod in Tile

Raised to surface with 1/2" Pipe

#7 - P. Pole N47°E 74.55'

#8 - 20" Elm S69°E 79.81'

#9 - P. Pole (5') S43°E 45.72'

#5 - 7" Elm N52°W 59.63'

1987 - M. McClung, LS 13037

Survey rec. L. 494, Pg. 625

(Osceola Co. Reg. of Deeds)

#9 - Treated Fen. Post S45°E 46.05'

#7 - P. Pole N45°E 74.5'

#10 - Tel. Box N35°W 64.4'

1995 - R.L. Wetherell, LS 24624

L.C.R.C. - L. 03, Pg. 283

Survey recorded L. 04, Pg. 014(Lake Co. Reg. of Deeds)

#11 - 4' Diameter Stone S87°W 93.66' (60d spike in crack)

#12 - 5" W. Pine S76°E 164.77'

#13 - 5" Elm N5°W 103.47'

#9 - Post S40°E 46.00'

1995 - M. McClung, LS 13037

L.C.R.C. - Liber "A", Pg. 396

Remonumentation for Osceola Co.

Found 1/2" Pipe over rod in tile.

Set Osceola Co. Monument

#14 - 12" W. Pine S28°W 116.45'

#7 - P. Pole N48°E 74.60'

#9 - P. Pole S44°E 46.13'

#15 - 6" Apple N78°E 118.42'