

**SURVEY & REMONUMENTATION**

**AUG 31 1999**

**SECTION**

**LAND CORNER RECORDATION CERTIFICATE**

FILING REQUIREMENT OF ACT 74, Mich. P.A. 1970

**RECORDED**  
**LAKE COUNTY, MI.**  
**LIBER 004 PAGE 0196**

For corners in Lake _____	Located in:	Corner Code#
1. Public Land Survey	T 18N R 11W	M-4
	T R	
	T R	
	T R	
2. Property Controlling in Section	T R	
	S T R	
3. Miscellaneous Property in Sec.	S T R	
	S T R	
4. Lot No. _____ Recorded Plat _____		
5. Private Claims _____		

**Jul 23 3 03 PM '99**

*Richard H. Dickson*  
**REGISTER OF DEEDS**

Register of Deeds Stamp & File Number

	A	B	C	D	E	F	G	H	I	J	K	L	M
1													
2	6	5	4	3	2	1							
3													
4	7	8	9	10	11	12							
5													
6	18	17	16	15	14	13							
7													
8	19	20	21	22	23	24							
9													
10	30	29	28	27	26	25							
11													
12	31	32	33	34	35	36							
13													

I, **Robert L. Wetherell**, in a field survey on June 1, 1999, do hereby certify that under requirements of P.A. 74, Michigan P.A. of 1970, the corner points mentioned in lines 1 and 2 above were in conformance with regulations and rules therefore as required in the current manual of survey instructions of the United States Department of the Interior, Bureau of Land Management or by decree of a Court of Law and/or that the corner points mentioned in lines 3, 4, and 5 above were in conformance with the rules of the Michigan Board of Land Surveyors or by a Decree Of a Court of Law; established, re-established, monumented, re-monumented, recovered, found as expressed below:

**M-4 - 1/4 Corner on West line of Section 12, T18N, R11W**

**A. Description of original monument and accessories and/or subsequent restoration:**

**1837 - J. Hodgson, G.L.O**  
#1 - 10" Beech S50°W 13 Links  
#2 - 10" Sugar N15°W 23 Links

**1990 - R.L. Wetherell, LS 24624**  
L.C.R.C. - L. 02, Pg. 339 (Osceola Co.)  
#3 - 10" R. Pine N79°W 34.76'  
#4 - P. Pole S85°E 51.95'  
#5 - 30" Maple N20°E 92.02'

**1996 - M. McClung, LS 13037**  
L.C.R.C. - Liber "A", Pg. 501 (Osceola Co. Remonumentation)  
#6 - Cherry Clump S78°E 30.90'  
#7 - 10" Ash N42°E 41.78'  
#3 - 12" Pine N82°W 34.50'  
#8 - 8" W. Ash N20°W 77.75'

**1987 - C. Cole, LS 17615**  
No monument or accessories given.  
Showed distance to C. 1/4 corner Sec. 12 of 2639.07'  
Showed distance to N.E. corner Sec. 12 of 2626.33'

**B. Description of corner evidence found and/or method applied in restoring or reestablishing corner:**

I found a 4" Concrete Monument in center of a North and South road and in an old fence line running East. I measured 2625.38 feet North to Section corner and 2639.07 feet to the C. 1/4 corner and 2631.92 feet South to Section corner.


Condition of the accessories are as follows: #1 Gone, #2 Gone, #3 Found in good condition, #4 Found in good condition, #5 Found in good condition, #6 Found in good condition, #7 Found in good condition, #8 Found in good condition.

**C. Description of monument for corner and accessories established to perpetuate locating the position of the corner:**

I accepted the 4" Concrete Monument as a substantial marker for the corner, and is accepted as careful and faithful re-establishment of the position of the original corner.

14" R. Pine N78°W 34.69' (60d spike in S. side) #3  
8" Ash N16°W 77.75' (60d spike in N.E. side) #8  
8" Ash N42°E 41.52' (60d spike in N. side) #7  
5" Ash S41°E 39.50' (60d spike in N.E. side)

RATIFIED BY THE LAKE CO. PEER REVIEW GROUP  
IN ACCORDANCE WITH P.A. 345  
CHAIRMAN *R.L.W.*  
DATE *7-20-99*

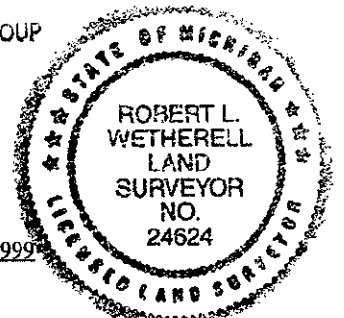

Signed by *Robert L. Wetherell*

Date July 21, 1999

Surveyor's Michigan License No. 24624