

LAND CORNER RECORDATION CERTIFICATE

FILING REQUIREMENT OF ACT 74, MICH. P.A.1970

FOR CORNERS OF--	LOCATED IN--	CORNER CODE NUMBER
1. PUBLIC LAND SURVEY	T. 18 N. R. 12 W.	I-5; I-7; J-7
2. PROPERTY CONTROLLING IN SECTION	14, T. 18 N. R. 12 W.	15
3. MISCELLANEOUS PROPERTY IN SECTION	, T. S. R. E. W.	
4. LOT NO. _____, RECORDED PLAT _____		
5. PRIVATE CLAIMS _____		

REGISTER OF DEEDS STAMP AND FILING NUMBER

I, Carl F. Roser, do hereby certify that under requirements of P.A. 74, Michigan P.A. of 1970, the corner points mentioned in lines 1 and 2 above were, in a field survey on May 5, 1975, established, re-established, monumented, re-monumented, recovered or restored as expressed below and in conformance with regulations and rules therefore as required in the current manual of survey instructions of the United States Department of the Interior, Bureau of Land Management or by a decree of a court of law. Furthermore, that the corner points mentioned in lines 3, 4 and 5 above were, in a field survey on _____, 19____, found, recovered, restored, established or re-established as expressed below and in conformance with the rules of the Michigan State Board of Registration for Land Surveyors or, by a Decree of a Court of law:

~~A. Description of original monument and accessories and of subsequent restoration~~
 C. (continued)

15

Found & accepted	3/8"x3/8" iron
Power Pole	S10°W 43.31
9" B. Oak	S45°W 53.63
Set cedar post w/loc. tag	
Due N	33

B. Description of corner evidence found and/or method applied in restoring or re-establishing corner:

- I-5 Found and accepted iron as recovered by R.L.S. Clint Cole. Corner falls in approximate center of King's Highway Gravel Company road.
- I-7 Found and accepted 1/2" pipe that falls in approximate center of road intersection N-S-E and fits approximate split of old R.O.W. fences.
- J-7 Found and accepted 8" end of Sucker Rod in approximate center of sand road intersection E-W-S.
- 15 Found and accepted iron by R.L.S. Clint Cole. Corner is in line with fence to North.

C. Description of monument for corner and accessories established to perpetuate locating the position of the corner:

I-5	I-7	J-7
Found & accepted triangular iron bar	Found & accepted 1/2" Pipe	Found iron & added DNR mon.
Power Pole S28°W 118.09	5" R. Pine N60°E 59.1	(buried)
6" W. Oak N68°E 46.94	13" R. Pine S45°E 105.9	16" B. Oak N50°W 60.60
U.S.G.S. BM TT96TEX 1930	Set cedar post w/loc. tag	7" R. Pine S45°E 77.00
S86°W 38.99	Due W 33	12" W. Oak S23°W 73.24
Set cedar post w/loc. tag Due E 33		Set cedar post w/loc. tag
		S45°E 45

SIGNED BY Carl F. Roser DATE 9-4-75

SURVEYOR'S MICHIGAN REGISTRATION NO. 12028

FOR STATE AND UNITED STATES AGENCIES:


SIGNED BY _____ DATE _____

CHIEF OF SURVEY PARTY

APPROVED AND SIGNED BY _____ DATE _____

MICHIGAN REGISTERED LAND SURVEYOR

(SEAL)

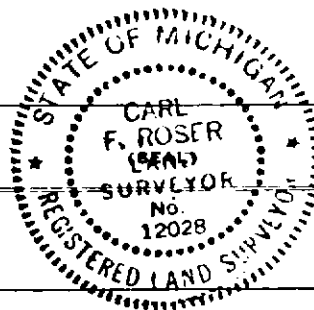

SURVEYOR'S MICHIGAN REGISTRATION NO. _____ CHERRY VALLEY TOWNSHIP
 LAKE COUNTY