

LAND CORNER RECORDATION CERTIFICATE

FILING REQUIREMENT OF ACT 74, MICH. P.A.1970

FOR CORNERS OF--	LOCATED IN--	CORNER CODE NUMBER
1. PUBLIC LAND SURVEY	T. 18 N. R. 12 W.	J-5; J-6; K-6
2. PROPERTY CONTROLLING IN SECTION 14	T. 18 N. R. 12 W.	2
3. MISCELLANEOUS PROPERTY IN SECTION	T. S. R. E. W.	
4. LOT NO. _____, RECORDED PLAT _____		
5. PRIVATE CLAIMS _____		

REGISTER OF DEEDS STAMP AND FILING NUMBER

I, Carl F. Roser, do hereby certify that under requirements of P.A. 74, Michigan P.A. of 1970, the corner points mentioned in lines 1 and 2 above were, in a field survey on September 5, 1974, established, re-established, monumented, re-monumented, recovered or restored as expressed below and in conformance with regulations and rules therefore as required in the current manual of survey instructions of the United States Department of the Interior, Bureau of Land Management or by a decree of a court of law. Furthermore, that the corner points mentioned in lines 3, 4 and 5 above were, in a field survey on _____, 19____, found, recovered, restored, established or re-established as expressed below and in conformance with the rules of the Michigan State Board of Registration for Land Surveyors or, by a Decree of a Court of law:

A. Description of original monument and accessories and/or subsequent restoration:

C. (continued)

2
Set 1"x36" Pipe & cedar post w/loc. tag
6" Maple N80°E 35.2
9" Oak S20°E 5.8

B. Description of corner evidence found and/or method applied in restoring or re-establishing corner:

- J-5 Reestablished corner 33'± west of R.O.W. fence southerly, which fits average line of old township road grade to south and on straight line between section corners to E & W. Fence corner remains 36' E & 35' N, fence remains E-W & S.
- J-6 Established center of section 14 at intersection of ¼ lines. There are fence remains westerly, Due N, 21'±. There is a marked line easterly, Due N, 36'±.
- K-6 Reestablished corner per standard B.L.M. instructions. Single proportionate to U.S. Single wire on cedar post, wire W & S on trees, is 66'-N and 22'-E.
- 2 Established corner per std. B.L.M. instructions. Old fence corner remains 15'-E & 47'-N.

C. Description of monument for corner and accessories established to perpetuate locating the position of the corner:

J-5	J-6	K-6
Set DNR Mon. & cedar post w/loc. tag	Set DNR Mon. & cedar post	Set DNR Mon. & cedar post
6" W. Oak N40°W 19.0	12" Oak S75°W 11.8	7" Oak N15°W 17.8
7" W. Oak N10°E 24.6	10" Oak N53°W 15.5	2" W. Pine N17°E 52.7
9" W. Oak S40°W 28.1	8" Oak N65°E 21.8	14" W. Oak S55°E 14.8
	Center of old N-S twp. road grade	Due E 7

SIGNED BY Carl F. Roser 9-4-75 DATE

SURVEYOR'S MICHIGAN REGISTRATION NO. 12028


FOR STATE AND UNITED STATES AGENCIES:

SIGNED BY _____ DATE _____

CHIEF OF SURVEY PARTY

APPROVED AND SIGNED BY _____ DATE _____

MICHIGAN REGISTERED LAND SURVEYOR

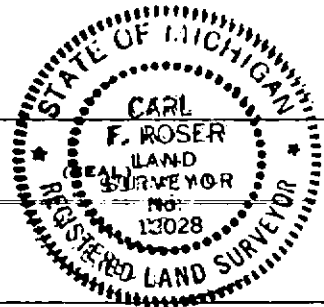

(SEAL)

SURVEYOR'S MICHIGAN REGISTRATION NO. _____

CHERRY VALLEY TOWNSHIP
LAKE COUNTY