

*land to Lansing Forestry*

STATE OF MICHIGAN  
DEPARTMENT  
OF  
NATURAL RESOURCES

LAND CORNER RECORD


LAKE COUNTY  
T 18 N R 12 W

DESCRIPTION OF CORNER North 1/4 corner - Section 6

CORNER MONUMENT Set DNR monument

DATE MONUMENT PLACED AND WITNESSED 6-12-72 ✓ ✓

WITNESSES TO CORNER..... J. Pine 8" ✓ S 04° W 35.2'  
S 08 E 35.7'

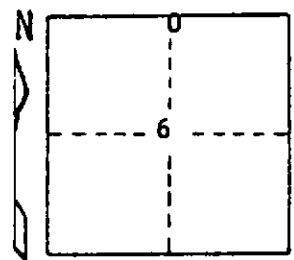


B. Oak 8" ✓ S 43 E 47.5'  
S 37 E 42.4'

AND

CIRCLE CORNER REGISTERED

DESCRIPTION IN DETAIL AS TO HOW CORNER WAS LOCATED AND IDENTIFIED OR RESTORED.

Corner re-established per standard BLM instructions. The South 1/4 corner, Section 31, T19N - R12W is West ~~7.6'~~ 15.20' ✓

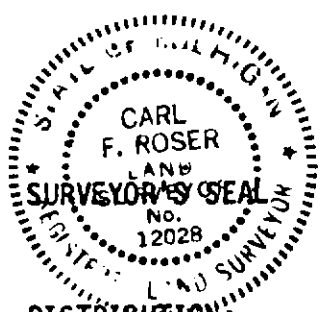

SIGNED Carl F. Roser DATE 6-19-72  
REGISTERED LAND SURVEYOR 12028

DISTRIBUTION:  
Forestry Division, Lansing

*Corrected  
CFR  
1-5-73*

R 4047  
MAY 2 1972