

STATE OF MICHIGAN
DEPARTMENT
OF
NATURAL RESOURCES

LAND CORNER RECORD

LAKE COUNTY
T 18 N R 12 W


DESCRIPTION OF CORNER NE corner - Section 6

CORNER MONUMENT Found 1 1/2" & 1/2" pipe. Added DNR monument (buried 6")

DATE MONUMENT PLACED AND WITNESSED 6-12-72

WITNESSES TO CORNER..... B. Oak 10" N 23 E 41.9'

B. Oak 18" N 86E 69.5'

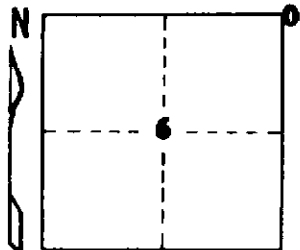


AND

CIRCLE CORNER REGISTERED

DESCRIPTION IN DETAIL AS TO HOW CORNER WAS LOCATED AND IDENTIFIED OR RESTORED.

Found recovered Brass corner of record. Corner is in road intersection, road W-N-S. The SE corner of Section 31, T19N - R12W is 15.2' West.

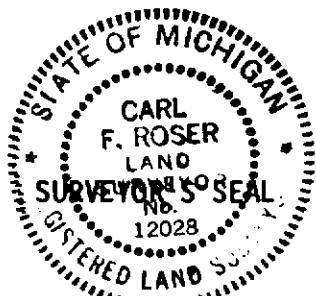

SIGNED

Carl F. Roser
REGISTERED LAND SURVEYOR **12028**

DATE

6-19-72

DISTRIBUTION:

Forestry Division, Lansing