

STATE OF MICHIGAN  
DEPARTMENT  
OF  
NATURAL RESOURCES

LAND CORNER RECORD

LAKE

— 18 N — COUNTY W  
T ——— R ———

SE corner - Section 7

DESCRIPTION OF CORNER

~~Found iron Pin post 26" long. Added DNR monument buried 4"~~

CORNER MONUMENT


6-9-72

DATE MONUMENT PLACED AND WITNESSED

W. Pins 4" N 38 W 79.9'

WITNESSES TO CORNER.....

B. Oak 25" N 35 E 44.21'

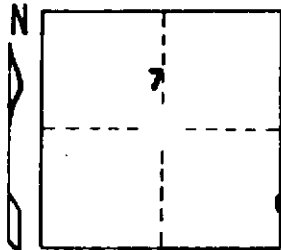


Power Poles S 65 W 44.30'

AND

CIRCLE CORNER REGISTERED

DESCRIPTION IN DETAIL AS TO HOW CORNER WAS LOCATED AND IDENTIFIED OR RESTORED.

Found recovered Brass corner of record.

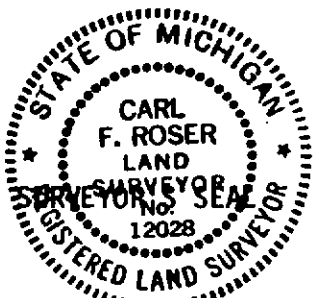

DISTRIBUTION:

SIGNED

*Carl F. Roser*

DATE

6-16-72

REGISTERED LAND SURVEYOR

Forestry Division, Lansing