

STATE OF MICHIGAN
DEPARTMENT
OF
NATURAL RESOURCES

LAND CORNER RECORD


LAKE COUNTY
T 18 N R 12 W

DESCRIPTION OF CORNER West 1/16 corner on South line - Section 7

CORNER MONUMENT Found 1/2" x 1/2" iron rod

DATE MONUMENT PLACED AND WITNESSED 6-19-72

WITNESSES TO CORNER..... 1 Oak 8" S 28 W 23.1'

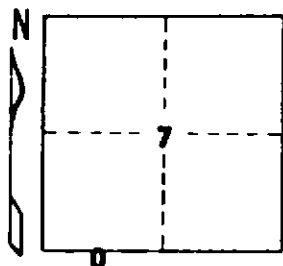

J Pine 6" S 35 E 52.3'


Spike in top
J Pine stump 6" S 02 W 32.9'

AND Ctr. E-W sand
road Due S 2'

CIRCLE CORNER REGISTERED

DESCRIPTION IN DETAIL AS TO HOW CORNER WAS LOCATED AND IDENTIFIED OR RESTORED.

Recovered Bob Griffin corner of record.

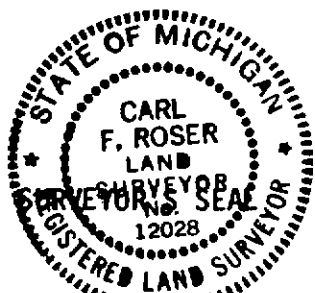

SIGNED

Carl F. Roser
REGISTERED LAND SURVEYOR 12028

DATE

6-20-72

DISTRIBUTION:

Forestry Division, Lansing