

STATE OF MICHIGAN
DEPARTMENT
OF
NATURAL RESOURCES

LAND CORNER RECORD


LAKE COUNTY
T 18 N R 12 W

DESCRIPTION OF CORNER East 1/4 corner - Section 7

CORNER MONUMENT Found 3/4" x 20" pipe. Added standard DNR monument

DATE MONUMENT PLACED AND WITNESSED 5-5-72

WITNESSES TO CORNER..... 26" White Pine S 10 E 71.2'

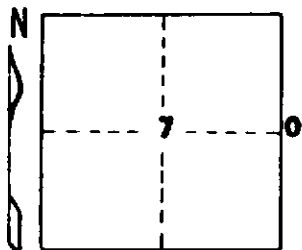

9" Black Oak N 65 E 39.7'

CL N-S sand rd Due W 5'

Squared cedar post Due W 33'


& location tag

AND

CIRCLE CORNER REGISTERED

DESCRIPTION IN DETAIL AS TO HOW CORNER WAS LOCATED AND IDENTIFIED OR RESTORED.

Accepted recovered corner which fits a computed position very close.

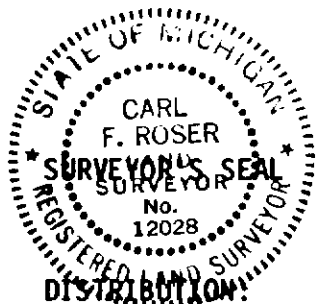

SIGNED

Carl F. Roser

DATE

5-12-72

REGISTERED LAND SURVEYOR 12028

Forestry Division, Lansing