

STATE OF MICHIGAN  
DEPARTMENT  
OF  
NATURAL RESOURCES

LAND CORNER RECORD


LAKE COUNTY  
T 18 N R 12 W

DESCRIPTION OF CORNER NE corner - Section 7

CORNER MONUMENT Found 1/2" x 24" pipe. Added DNR monument (buried)

DATE MONUMENT PLACED AND WITNESSED 5-10-72

WITNESSES TO CORNER..... J. Pine 9" S 70 E 46.6'

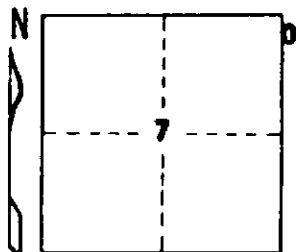

\* J. Pine 14" S.25 E 75.8'


\* J. Pine 15" S 10 E 78.9'

AND J. Pine 9" S 55 W 64.2'

CIRCLE CORNER REGISTERED \* Unknown surveyor Bts with nail in - cut X

DESCRIPTION IN DETAIL AS TO HOW CORNER WAS LOCATED AND IDENTIFIED OR RESTORED.

**Found recovered Blass corner of record.**

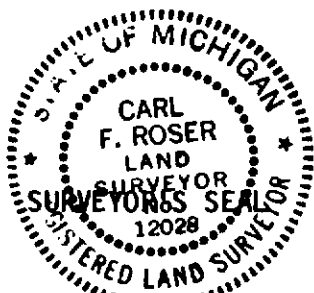

SIGNED

*Carl F. Roser*

DATE

5-17-72

REGISTERED LAND SURVEYOR 12028

DISTRIBUTION:

Forestry Division, Lansing