

STATE OF MICHIGAN
DEPARTMENT
OF
NATURAL RESOURCES

LAND CORNER RECORD


LAKE _____ COUNTY _____
T 18 N _____ R 12 W

DESCRIPTION OF CORNER North 1/16 corner on East line - Section 7

CORNER MONUMENT Set 1" x 36" pipe (6" deep)

DATE MONUMENT PLACED AND WITNESSED 5-5-72

WITNESSES TO CORNER..... B. Oak 3" N 55 E 18.5'

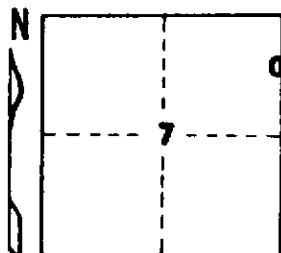

B. Oak 7" S 10 E 57.9'


CL N-S sand road Due W 6'

AND

CIRCLE CORNER REGISTERED

DESCRIPTION IN DETAIL AS TO HOW CORNER WAS LOCATED AND IDENTIFIED OR RESTORED.

Established corner per standard NLM instructions.

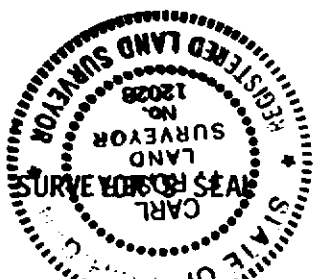

DISTRIBUTION:

Forestry Division, Lansing

SIGNED

Carl F. Rover

REGISTERED LAND SURVEYOR

DATE

5-12-72