

LAND CORNER RECORDATION CERTIFICATE
FILING REQUIREMENT OF ACT 74, MICH. P.A.1970

FOR CORNERS OF-- LOCATED IN-- CORNER CODE NUMBER
1. PUBLIC LAND SURVEY T. 18 N. R. 12 W. J-1; K-1; L-1
2. PROPERTY CONTROLLING IN SECTION 4 T. 18 N. R. 12 W. 2
3. MISCELLANEOUS PROPERTY IN SECTION T. N. S. R. E. W.
4. LOT NO. , RECORDED PLAT
5. PRIVATE CLAIMS

REGISTER OF DEEDS STAMP AND FILING NUMBER

I, Carl F. Roser do hereby certify that under requirements of P.A. 74, Michigan P.A. of 1970, the corner points mentioned in lines 1 and 2 above (identified with circles on index code diagram - over) were, in a field survey on 6-5-1973, established, re-established, monumented, re-monumented, recovered or restored as expressed below and in conformance with regulations and rules therefore as required in the current manual of survey instructions of the United States Department of the Interior, Bureau of Land Management or by a decree of a court of law.

A. Description of original monument and accessories and/or subsequent restoration:

B. Description of corner evidence found and/or method applied in restoring or re-establishing corner:

- J-1 Reestablished corner per standard B.L.M. Instructions.
K-1 Reestablished corner per standard B.L.M. Instructions.
L-1 Reestablished corner per standard B.L.M. Instructions.
2 Established corner per standard B.L.M. Instructions.

C. Description of monument for corner and accessories established to perpetuate locating the position of the corner:

J-1 Set DNR Mon & Ced Gd. Post 14" Oak S15W 10.5' 12" W. Oak S30E 16.2' S 1/4 cor Sec 35 Due W 41.73'
K-1 Set DNR Mon & Ced Gd. Post 10" W. Oak S45E 22.0' 16" B. Oak S70W 31.5' Cor Secs 35 & 36 Due W 53.23
2 Set 1"x4 1/2' Pipe & Ced. Gd. Post w/loc tag 14" Cedar S73E 14.2' 13" Cedar S27E 10.3' E 1/16 on S line 33 Due W 9.3
L-1 Set DNR Mon & Ced. Gd. Post 16" R. Oak S58E 52.4 12" W. Oak S32W 23.1 S 1/4 Sec. 36 Due W 26.62


SIGNED BY Carl F. Roser DATE 7-16-73

SURVEYOR'S MICHIGAN REGISTRATION NO. 12028

FOR STATE AND UNITED STATES AGENCIES:

SIGNED BY CHIEF OF SURVEY PARTY DATE

APPROVED AND SIGNED BY MICHIGAN REGISTERED LAND SURVEYOR DATE

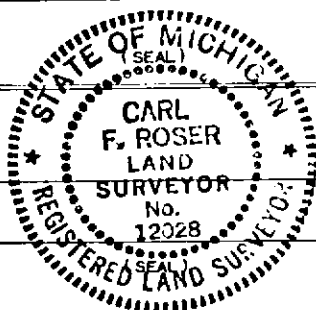

SURVEYOR'S MICHIGAN REGISTRATION NO.