

LAND CORNER RECORDATION CERTIFICATE

FILING REQUIREMENT OF ACT 74, MICH. P.A.1970

FOR CORNERS OF--:	LOCATED IN--:	CORNER CODE NUMBER
1. PUBLIC LAND SURVEY	T. 18 N. R. 12 W.	H-11; I-11
2. PROPERTY CONTROLLING IN SECTION 27	T. 18 N. R. 12 W.	7; 15; 16
3. MISCELLANEOUS PROPERTY IN SECTION	T. N. S. R. E. W.	
4. LOT NO. _____, RECORDED PLAT _____		
5. PRIVATE CLAIMS _____		

REGISTER OF DEEDS STAMP AND FILING NUMBER

I, Carl F. Roser, do hereby certify that under requirements of P.A. 74, Michigan P.A. of 1970, the corner points mentioned in lines 1 and 2 above were, in a field survey on July 19, 1977, established, re-established, monumented, re-monumented, recovered or restored as expressed below and in conformance with regulations and rules therefore as required in the current manual of survey instructions of the United States Department of the Interior, Bureau of Land Management or by a decree of a court of law. Furthermore, that the corner points mentioned in lines 3, 4 and 5 above were, in a field survey on _____, 19____, found, recovered, restored, established or re-established as expressed below and in conformance with the rules of the Michigan State Board of Registration for Land Surveyors or, by a Decree of a Court of law:

~~As Description of original corner and accessories...~~
 C. (continued)

	15	16
Fd. 1/2" pipe, raised		Set 5/8"X40"Rod w/ R.L.S. Cap
w/3/8" Cabin spk.		11" X.Oak S21°E 56.6
13" B.Oak N53°W 51.0		12" W.Oak N34°E 74.2
11" W.Oak N60°E 44.4		Set Ced.Post w/loc.tag
Set Ced.Post w/loc.tag		Due N 33'
Due N 33'		Ctr. E-W gravel rd.
		Due N 2'+

- B. Description of corner evidence found and/or method applied in restoring or re-establishing corner:
- H-11 Found and accepted U.S. Forest Service Monument, buried in E-W road.
 - I-11 Recovered U.S. Forest Service Monument of record, buried in near S'ly edge of road intersection E-W-N.
 - 7 Recovered & accepted iron set by C.Cole
 - 15 Fd. & accepted 1/2" pipe for 1/8 Corner. Corner falls in ctr. of E-W gravel road.
 - 16 Estab. 1/8 Cor. per Std. B.L.M. instructions.

C. Description of monument for corner and accessories established to perpetuate locating the position of the corner:

	H-11	I-11
Fd. 5"X5" Conc.Mon buried 1 1/2' raised w/1/2"X16"pipe		Fd. 5"X5" Sq. Conc. Mon. w/bronze disk
18" B.Oak N07°W 70.8		16" W.Oak N27°E 100.2
8" B.Oak S37°E 77.7		8" W.Oak S20°E 82.23
1" Pipe Due S 50.8		11" W.Oak S60°W 61.58
Ced.Post w/loc.tag		U.S.F.S. Post w/sign&Loc.Tag
Due S 33'		Due S 33'
		Fd. 1" "T" iron in ctr. N-S bit. Rd.
		6" B.Oak S65°E 32.8
		5" B.Oak S40°E 39.5
		Set Ced.w/loc.tag beside fd. iron Due W 33'

SIGNED BY Carl F. Roser DATE 5-15-78

SURVEYOR'S MICHIGAN REGISTRATION NO. 12028

FOR STATE AND UNITED STATES AGENCIES:


SIGNED BY _____ DATE _____

CHIEF OF SURVEY PARTY

APPROVED AND SIGNED BY _____ DATE _____

MICHIGAN REGISTERED LAND SURVEYOR

(SEAL)

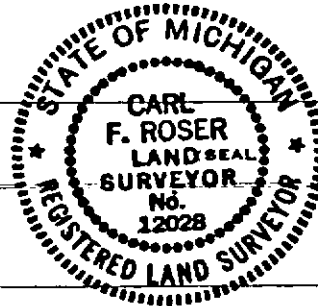

SURVEYOR'S MICHIGAN REGISTRATION NO. _____

CHERRY VALLEY TOWNSHIP
LAKE COUNTY