

# LAND CORNER RECORDATION CERTIFICATE

## FILING REQUIREMENT OF ACT 74, MICH. P.A.1970

FOR CORNERS OF --:	LOCATED IN --:	CORNER CODE NUMBER
1. PUBLIC LAND SURVEY _____	T. 18 <sup>N.</sup> <sub>0.</sub> , R. 12 <sup>W.</sup> <sub>0.</sub>	D-3; E-3; E-4; F-3
2. PROPERTY CONTROLLING IN SECTION _____	9, T. 18 <sup>N.</sup> <sub>0.</sub> , R. 12 <sup>W.</sup> <sub>0.</sub>	1
3. MISCELLANEOUS PROPERTY IN SECTION _____	T. _____ <sup>N.</sup> <sub>S.</sub> , R. _____ <sup>E.</sup> <sub>W.</sub>	
4. LOT NO. _____, RECORDED PLAT _____		
5. PRIVATE CLAIMS _____		

REGISTER OF DEEDS STAMP AND FILING NUMBER

I, Carl F. Roser, do hereby certify that under requirements of P.A. 74, Michigan P.A. of 1970, the corner points mentioned in lines 1 and 2 above were, in a field survey on May 6, 1977, established, re-established, monumented, re-monumented, recovered or restored as expressed below and in conformance with regulations and rules therefore as required in the current manual of survey instructions of the United States Department of the Interior, Bureau of Land Management or by a decree of a court of law. Furthermore, that the corner points mentioned in lines 3, 4 and 5 above were, in a field survey on \_\_\_\_\_, 19\_\_\_\_, found, recovered, restored, established or re-established as expressed below and in conformance with the rules of the Michigan State Board of Registration for Land Surveyors or, by a Decree of a Court of law:

A = Description of original monument and accessories and/or subsequent restoration:  
 C. (continued)

	F-3	1
	Set DNR Mon & Ced. Post	Set 40"x5/8" rod w/RLS Cap & Ced. Post w/Loc. tag
	6" Cedar N80°W 24.6	5" Cedar N20°W 44.5
	5" Cedar N20°W 36.2	9" Hemlock S87°E 47.8
	13" Cedar S05°E 13.5	6" Cedar S63°W 16.6
	E-W Rand. Due N 1.4	E-W Rand. Due N 2'

B. Description of corner evidence found and/or method applied in restoring or re-establishing corner:


- D-3 Fd. 1/2" rod as set by R.L.S., C. Cole per preliminary numbers from Dept. retracement survey (working drawing).
- E-3 Fd. 1/2" rod as set by R.L.S., C. Cole per preliminary numbers from Dept. retracement survey (working drawing).
- E-4 Re-estab. 1/4 Cor. per std. B.L.M. instructions.
- 1 Estab. 1/8 Cor. per std. B.L.M. instructions.
- F-3 Re-estab. 1/4 Cor. per std. B.L.M. instructions.

C. Description of monument for corner and accessories established to perpetuate locating the position of the corner:

	D-3	E-3	E-4
	Fd. 1/2"x20" iron rod; added DNR Mon. & Ced. Post	Fd. 1/2"x18" rod; added DNR Mon. & Ced. Post	Set DNR Mon. & Ced. Post
	7" Cedar N10°E 43.82	4" Cedar N60°W 23.75	9" Cedar N50°W 19.8
	7" Maple N70°E 45.32	8" Maple N85°E 42.51	7" Cedar in Clp. of (2) N15°E 14.9
	4" Maple S85°W 16.74	12" Maple S30°E 67.69	6" Cedar N30°E 27.5
		6" Cedar S55°E 7.60	N'y edge Rv. Due S 17'
		Rand. E Due N 2.8	N-S Rand. Due W 1.6
		Rand. S Due W 2.4	

SIGNED BY Carl F. Roser DATE 5-15-78

SURVEYOR'S MICHIGAN REGISTRATION NO. 12028

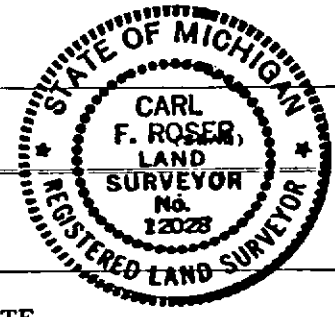

FOR STATE AND UNITED STATES AGENCIES:

SIGNED BY \_\_\_\_\_ DATE \_\_\_\_\_  
CHIEF OF SURVEY PARTY

APPROVED AND SIGNED BY \_\_\_\_\_ DATE \_\_\_\_\_  
MICHIGAN REGISTERED LAND SURVEYOR

(SEAL)

SURVEYOR'S MICHIGAN REGISTRATION NO. \_\_\_\_\_ CHERRY VALLEY TOWNSHIP  
 LAKE COUNTY