

LAND CORNER RECORDATION CERTIFICATE

FILING REQUIREMENT OF ACT 74, MICH. P.A.1970

FOR CORNERS OF--:	LOCATED IN--:	CORNER CODE NUMBER
1. PUBLIC LAND SURVEY _____	T. 18 N. R. 12 W.	E-7; G-5; G-6; H-5
2. PROPERTY CONTROLLING IN SECTION _____	16, T. 18 N. R. 12 W.	14
3. MISCELLANEOUS PROPERTY IN SECTION _____	T. _____ N. S. R. _____ E. W.	
4. LOT NO. _____, RECORDED PLAT _____		
5. PRIVATE CLAIMS _____		

REGISTER OF DEEDS STAMP AND FILING NUMBER

I, Carl F. Roser, do hereby certify that under requirements of P.A. 74, Michigan P.A. of 1970, the corner points mentioned in lines 1 and 2 above were, in a field survey on May 5, 1977, established, re-established, monumented, re-monumented, recovered or restored as expressed below and in conformance with regulations and rules therefore as required in the current manual of survey instructions of the United States, Department of the Interior, Bureau of Land Management or by a decree of a court of law. Furthermore, that the corner points mentioned in lines 3, 4 and 5 above were, in a field survey on _____, 19____, found, recovered, restored, established or re-established as expressed below and in conformance with the rules of the Michigan State Board of Registration for Land Surveyors or, by a Decree of a Court of law:

A. Description of original monument and accessories and/or subsequent restoration:

C. (continued)	H-5	14	
	Fd. conc. Mon.; added	Set 5/8"X40" rod w/RLS Cap &	
	Ced. Post w/Loc. Tag	Ced. Post w/Loc. Tag	
	17" W. Pine N62°W 24.30	11" Cedar N30°E 29.5	
	12" Cedar N30°E 50.41	7" Cedar S05°W 14.4	
	11" R. Oak S45°W 13.67	5" Cedar S85°W 35.6	
	S'yly edge 17' wide shallow stream flowing W'yly	N-S Rand. Due W 25.4	
	Due N 14'		

B. Description of corner evidence found and/or method applied in restoring or re-establishing corner:


- E-7 Fd. Bed rail; probably by G. Johnson. Old Corner fence post (Fn. N-S-W) is 47'+ So. This iron is in approx. ctr. of 66'+ Wd. opening cut E'yly in 1931.
- G-5 Re-estab. Sec. Cor. by Double Proportion to U.S.
- G-6 Re-estab. 1/4 Cor. per Std. B.L.M. instructions.
- H-5 Accepted Conc. Mon. by R.L.S., C.Cole, who found an iron pin.
- 14 Estab. 1/8 Cor. per Std. B.L.M. instructions.

C. Description of monument for corner and accessories established to perpetuate locating the position of the corner:

	E-7	G-5		G-6
Fd. Bed Rail; added		Set DNR Mon. & Ced. Post		Set DNR Mon. & Ced. Post
DNR Mon. & Ced. Post		7" Cedar N50°E 33.9		8" Cedar N10°W 18.3
7" Cedar N20°E 38.9		9" Cedar S22°E 39.1		7" Cedar N40°E 30.6
8" Cedar N70°E 87.6		5" Cedar S85°W 30.6		9" Cedar S10°W 6.7
11" Cedar S22°E 69.1		E-W Rand. Due N 5.7		N-S Rand. Due W 18'
Ctr. 4' ditch N&S				
	Due W 5'			
Old N-S Fn.	Due E 1'+			

SIGNED BY Carl F. Roser DATE 5-15-78

SURVEYOR'S MICHIGAN REGISTRATION NO. 12028

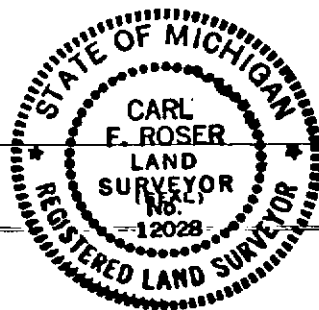

FOR STATE AND UNITED STATES AGENCIES:

SIGNED BY _____ DATE _____

APPROVED AND SIGNED BY _____ DATE _____

(SEAL)
CHERRY VALLEY TOWNSHIP
LAKE COUNTY

SURVEYOR'S MICHIGAN REGISTRATION NO. _____