

# LAND CORNER RECORDATION CERTIFICATE

## FILING REQUIREMENT OF ACT 74, MICH. P.A.1970

FOR CORNERS OF--	LOCATED IN--	CORNER CODE NUMBER	
1. PUBLIC LAND SURVEY	T. 18 N. R. 12 W.	A-8; B-6; C-6; C-8	
2. PROPERTY CONTROLLING IN SECTION	18, T. 18 N. R. 12 W.	7; 14	
3. MISCELLANEOUS PROPERTY IN SECTION	T. S. R. E. W.		
4. LOT NO.	RECORDED PLAT		
5. PRIVATE CLAIMS			

REGISTER OF DEEDS STAMP AND FILING NUMBER

I, Carl F. Roser, do hereby certify that under requirements of P.A. 74, Michigan P.A. of 1970, the corner points mentioned in lines 1 and 2 above were, in a field survey on July 19, 1977, established, re-established, monumented, re-monumented, recovered or restored as expressed below and in conformance with regulations and rules therefore as required in the current manual of survey instructions of the United States Department of the Interior, Bureau of Land Management or by a decree of a court of law. Furthermore, that the corner points mentioned in lines 3, 4 and 5 above were, in a field survey on \_\_\_\_\_, 19\_\_\_\_, found, recovered, restored, established or re-established as expressed below and in conformance with the rules of the Michigan State Board of Registration for Land Surveyors or, by a Decree of a Court of law:

~~A. Description of original monument and/or subsequent restoration~~  
 C. (continued)


<u>C-8</u> Fd. 1" pipe & old large ced. post	<u>7</u> Set 5/8"X40" rod w/RLS cap & Ced. Post w/loc. tag	<u>14</u> Set 5/8"X40" rod w/RLS cap & Ced. Post w/loc. tag
12" B.Oak S65°E 11.9	8" B.Oak N65°E 8.3	12" Maple S65°E 31.6
3" Pipe (Gasline Marker) N15°W 59.9	9" B.Oak S15°E 31.6	12" W.Pine S15°W 47.2
Fn. Cor. (N-S&W) Due W 22'	Ctr. N-S Trail Due W 7'	Ctr. of old R.R. grade (NNW-SSE) Due E 32'+

- B. Description of corner evidence found and/or method applied in restoring or re-establishing corner:
- A-8 Fd. Ir. that fits Blass Wits. (1952).
  - B-6 Recovered & accepted iron set by C.Cole, 1975, 44'N & 18'E of old fence corner.
  - C-6 Restore corner per standard B.L.M. instructions.
  - C-8 Fd. & accepted 1" pipe.
  - 7 Established Corner per standard B.L.M. instructions.
  - 14 Etab. 1/8 Cor per Std. B.L.M. instructions.

C. Description of monument for corner and accessories established to perpetuate locating the position of the corner:

<u>A-8</u> Fd. 1/2"X1/2" sq. iron	<u>B-6</u> Fd. 1/2"Rod w/RLS cap	<u>C-6</u> Set DNR Mon. & Ced. Post
7" W.Oak N55°W 42.30	Added Ced. Post w/loc. tag	13" R.Pine Due E 15.85
7" R. Pine S50°W 43.15	19" W.Pine N20°W 27.19	4" W.Pine S10°W 64.95
16" B. Oak N85°W 42.57	8" W.Pine S10°W 71.97	13" B.Oak S35°E 3.09
New fn. E'ly Due N 8'+	Ctr. E-W dirt rd. Due S 18'	Ctr. E-W dirt rd. Due S 21'
Old fn. W'ly Due N 12'+	Fd. 1/2"X3/8" Ir. East 49.9	

SIGNED BY Carl F. Roser 5-15-78 DATE \_\_\_\_\_  
 SURVEYOR'S MICHIGAN REGISTRATION NO. 12028

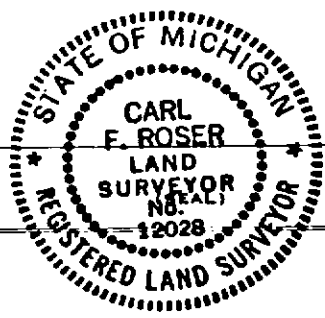

FOR STATE AND UNITED STATES AGENCIES:  
 SIGNED BY \_\_\_\_\_ DATE \_\_\_\_\_  
 CHIEF OF SURVEY PARTY  
 APPROVED AND SIGNED BY \_\_\_\_\_ DATE \_\_\_\_\_  
 MICHIGAN REGISTERED LAND SURVEYOR (SEAL)

SURVEYOR'S MICHIGAN REGISTRATION NO. \_\_\_\_\_ CHERRY VALLEY TOWNSHIP  
 LAKE COUNTY