

LAND CORNER RECORDATION CERTIFICATE

FILING REQUIREMENT OF ACT 74, MICH. P.A.1970

FOR CORNERS OF--:	LOCATED IN--:	CORNER CODE NUMBER
1. PUBLIC LAND SURVEY	T. 18 N. R. 12 W.	G-7; G-8; H-7
2. PROPERTY CONTROLLING IN SECTION	T. N. R. W.	
3. MISCELLANEOUS PROPERTY IN SECTION	T. N. S. R. E. W.	
4. LOT NO. _____, RECORDED PLAT _____		
5. PRIVATE CLAIMS _____		

REGISTER OF DEEDS STAMP AND FILING NUMBER

I, Carl F. Roser, do hereby certify that under requirements of P.A. 74, Michigan P.A. of 1970, the corner points mentioned in lines 1 and 2 above were, in a field survey on May 5, 1977, established, re-established, monumented, re-monumented, recovered or restored as expressed below and in conformance with regulations and rules therefore as required in the current manual of survey instructions of the United States Department of the Interior, Bureau of Land Management or by a decree of a court of law. Furthermore, that the corner points mentioned in lines 3, 4 and 5 above were, in a field survey on _____, 19____, found, recovered, restored, established or re-established as expressed below and in conformance with the rules of the Michigan State Board of Registration for Land Surveyors or, by a Decree of a Court of law:

~~As exceptions of original and/or subsequent restoration~~
 C. (continued) H-7

- Fd. R.R. Rail (on end); added
- Ced. Post w/loc. tag
- 11" W.Oak N15°W 26.3
- 8" W.Oak S12°W 54.5
- 22" W.Pine S73°W 104.8
- Ctr. old N-S R.R. grade (Trail rd.)
- Due W 91'

B. Description of corner evidence found and/or method applied in restoring or re-establishing corner:

- G-7 Fd. 3/4" X 3/4" X 48" angle Ir. that fits dbl. across recovered Geo. Johnson 1/8 Cor. & 1/4 Cor. to East.
- G-8 Recovered two 3" pointed post bottoms (side by side in muck), one Geo. Johnson B.T. & U.S.B.T. Ced. stump SW & stump hummock (probably U.S.) NE. Johnson B.T. is now dead, being a 4" Tam. partially broken off & leaning. Fits U.S. stream tie 85 Links So. good original Govt. Cor.
- H-7 Recovered R.R. Rail, 16" long, by G. Johnson in 1916; Johnson W.Oak, N8°E, 57.4; recently cut down.

C. Description of monument for corner and accessories established to perpetuate locating the position of the corner:

G-7	G-8
Fd. iron; added DNR Mon. & Ced. Post	Fd. pointed stk. bottoms; added DNR Mon. & Ced. Post
12" Tamarack N17°W 33.6	10" W. Birch N60°E 15.80
11" Cedar S40°E 57.1	6" Tam. N70°W 15.50
7" W.Oak S40°W 49.9	8" Cedar N30°W 17.7
Ctr. of old over-grown E-W	10" Cedar N75°E 21.1
4-rod Swp. rd. Due S 8' (+3')	9" Cedar S60°W 19.7
	Ctr. old N-S RR grade Due E 50'
	N-S Rand Due W 18.5
	N'y edge of 13' Stream flowing w'ly
	Due S 35'+


SIGNED BY Carl F. Roser 5-15-78 DATE _____

SURVEYOR'S MICHIGAN REGISTRATION NO. 12028

FOR STATE AND UNITED STATES AGENCIES:

SIGNED BY _____ DATE _____
CHIEF OF SURVEY PARTY

APPROVED AND SIGNED BY _____ DATE _____
MICHIGAN REGISTERED LAND SURVEYOR

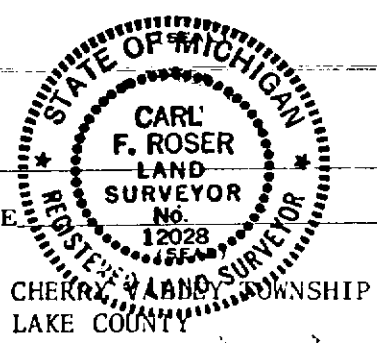

SURVEYOR'S MICHIGAN REGISTRATION NO. _____

MAY PLACE SKETCH ON BACK OR ATTACHED SHEET