

REMONUMENTATION

NOV 21 1997

COMMISSION

LIBER 004 PAGE 0071

LAND CORNER RECORDATION CERTIFICATE
Filing Requirement of Act 74, Mich. P.A. 1970

For corners in

Table with columns: (County), Located In: (18N, 12W), Corner Code # (C-7). Rows include Public Land Survey, Property Controlling in Section, Miscellaneous Property in Sec., Lot No., and Private Claims.

REGISTER OF DEEDS
RECORDED LAKE COUNTY, MI
OCT 29 2 59 PM 1997
Register of Deeds Stamp & File Number

Robert L. Wetherell September 23, 1997

I, Robert L. Wetherell, in a field survey on September 23, 1997, do hereby certify that under requirements of P.A. 74, Michigan P.A. of 1970, the corner points mentioned in lines 1 and 2 above were in conformance with regulations and rules therefore as required in the current manual of survey instructions of the United States Department of the Interior, Bureau of Land Management or by a decree of a Court of Law and/or that the corner points mentioned in lines 3, 4 and 5 above were in conformance with the rules of the Michigan Board of Land Surveyors or by a Decree of a Court of Law; established, re-established, monumented, re-monumented, recovered, found as expressed below:

Grid table with columns A-M and rows 2-13. A dot is marked at row 8, column C.

NOTE: Not more than 4 corners, all in the same town and range, may be recorded on this certificate.

A. Description of original monument and accessories and/or subsequent restoration.


- 1838 - J. Hodgson, G.L.O. #1 - 12" W. Oak N64°W 24 Links #2 - 6" Maple S65°E 30 Links 1915 - George Johnson, Co. Sur. 3/4" Rod, 40" Long #3 - 30" W. Pine Stump S51°W 98' #4 - 30" W. Pine Stump N33°W 132' 1929 - George Johnson, Co. Sur. #5 - 10" Cherry N19°30'E 102.7' #6 S.E. Cor. School Hse. N57°15'W 91.8' #7 Pine Stump S12°45'W 99.5' 1951 - George Blass, LS 5489 Found 3/4" Pipe #5 - 12" Cherry N20°E 102.7' #7 - 24" Pine Stump S13°W 97.5' #8 - 30" Pine Stump S51°W 64.00' 1978 - Carl Roser, LS 12028 Found 3/4" Pipe L.C.R.C. Liber 02, Page 332. #6 - S.E. cor. School Hse. N55°W 90.5' #9 - 5" W. Pine N25°W 72.20' #5 - 18" Cherry N20°E 103.22' #10 - Cedar Post North 33.00'

B. Description of corner evidence found and/or method applied in restoring or reestablishing corner:

C-7 - Section corner common to Sections 17, 18, 19 & 20, T18N, R12W, Lake Co., Mi.

I found a 3/4" pipe in center of East and West gravel road.

Condition of the accessories are as follows: #1 Gone, #2 gone, #3 Gone, #4 Gone, #5 gone, #6 Found in good condition, #7 Found in good condition, #8 Gone, #9 Found in good condition, #10 Found in good condition.

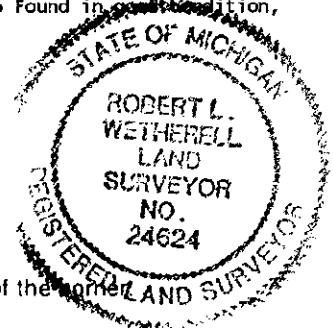

C. Description of monument for corner and accessories established to perpetuate locating the position of the corner:

C-7 - Section corner common to Sections 17, 18, 19 & 20, T18N, R12W, Lake Co., Mi.

I replaced the 3/4" pipe with a 3/4" x 24" rebar with Lake County Brass Cap, and is accepted as a careful and faithful re-establishment of the position of the original corner.

- 13" W. Pine N25°W 72.14' (60d spike over nail and bottle cap) #9
17" W. Oak N40°E 122.23' (60d spike in S.E. side)
3" Maple S49°W 91.4' (center of tree)
8" J. Pine S41°E 41.51' (60d spike in S.W. side)
Southeast corner School Foundation N52°W 90.32'

RATIFIED BY THE LAKE CO. PEER REVIEW GROUP IN ACCORDANCE WITH P.A. 345 CHAIRMAN R.W. DATE 10-23-97

Signed by Robert L. Wetherell

Date 10-28-97

Surveyor's Michigan License No. 24624