

NOV 21 1997

COMMISSION

LIBER 004 PAGE 0070

LAND CORNER RECORDATION CERTIFICATE
Filing Requirement of Act 74, Mich. P.A. 1970


For corners in

Table with columns: Lake (County), Located In: (18N, 12W), Corner Code (D-7). Rows include Public Land Survey, Property Controlling in Section, and Miscellaneous Property in Sec.

RECORDED LAKE COUNTY, MI.
REGISTER OF DEEDS
Register of Deeds Stamp File Number

- 4. Lot No. , Recorded Plat
5. Private Claims

I, Robert L. Wetherell, in a field survey on September 23, 1997, do hereby certify that under requirements of P.A. 74, Michigan P.A. of 1970, the corner points mentioned in lines 1 and 2 above were in conformance with regulations and rules therefore as required in the current manual of survey instructions of the United States Department of the Interior, Bureau of Land Management or by a decree of a Court of Law and/or that the corner points mentioned in lines 3, 4 and 5 above were in conformance with the rules of the Michigan Board of Land Surveyors or by a Decree of a Court of Law, established, re-established, monumented, re-monumented, recovered, found as expressed below:

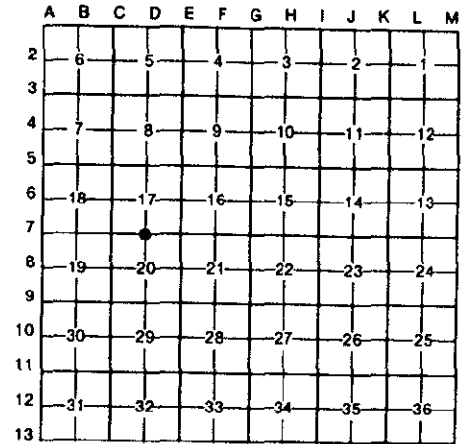

NOTE: Not more than 4 corners, all in the same town and range, may be recorded on this certificate.

A. Description of original monument and accessories and/or subsequent restoration:

D-7 - 1/4 Corner common to Sections 17 & 20, T18N, R12W, Lake Co., Mi.

- 1838 - John Hodgson, G.L.O. 1951 - George Blass, LS 5489 1978 - Carl Roser, LS 12028
#1 - 8" Cedar N4°W 11 Links Found Old Pump Cylinder. L.C.R.C. Liber 02, Pg. 343
#2 - 8" Cedar N31°E 8 Links Placed 7/8" rod above Found 5/8" Iron Rod
1930 m/l - George Johnson, Co. Sur. #3 - 10" Elm N1°W 180.2' #5 - 14" R. Pine N5°E 36.57'
7/8" Rod, 36" Long #6 - 10" W. Pine N55°E 64.78'
#3 - 10" Elm N1°30'W 108.25' #7 - Power Pole S25°E 61.51'
#4 - 40" P. Stump S64°W 138' #8 - Cedar Post North 33.00'

B. Description of corner evidence found and/or method applied in restoring or reestablishing corner:

D-7 - 1/4 Corner common to Sections 17 & 20, T18N, R12W, Lake Co., Mi.

I found a pump cylinder with a 1/2" rod with aluminum collar on top drive through cylinder. Corner is in the intersection of roads East, West and South and in line with old fence to the North.

Condition of the accessories are as follows: #1 gone, #2 gone, #3 Gone, #4 Found in good condition, #5 Found in good condition, #6 Found in good condition, #7 Found in good condition, #8 Found in good condition.


RATIFIED BY THE LAKE CO. PEER REVIEW GROUP
IN ACCORDANCE WITH P.A. 345
CHAIRMAN R&W
DATE 10-23-97

C. Description of monument for corner and accessories established to perpetuate locating the position of the corner:

D-7 - 1/4 Corner common to Sections 17 & 20, T18N, R12W, Lake Co., Mi.

I drove a Lake County Brass Cap on the 1/2" Rod with aluminum collar and left in the pump cylinder, and is accepted as a careful and faithful re-establishment of the position of the original corner.

- 11" W. Pine S54°W 58.14' (60d spike in N.W. side)
20" R. Pine N11°E 36.35' (60d spike in E. side) #5
18" W. Pine N60°E 64.75' (60d spike in N.W. side) #6
Power Pole S22°E 61.67' Found nail and bottle cap in S.W. side) #7
9" R. Pine S14°E 125.00' (60d spike in W. side)

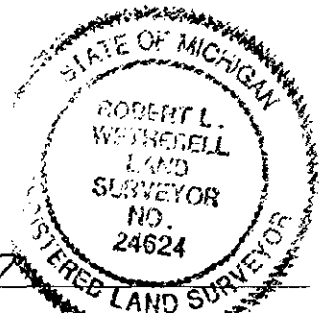

igned by Robert L. Wetherell

Date 10-28-97

urveyor's Michigan License No. 24624