

COMMISSION
REMONUMENTATION

LAND CORNER RECORDATION CERTIFICATE
Filing Requirement of Act 74, Mich. P.A. 1970

LIBER 003 PAGE 0270


For corners in APR 0 1 1995

| Lake | County | Located In: | | Corner Code # |
|------------------------------------|--------|-------------|-----|---------------|
| | | 18N | 12W | |
| 1. Public Land Survey | | T | R | G-3 |
| | | T | R | |
| | | T | R | |
| | | T | R | |
| 2. Property Controlling in Section | S | T | R | |
| | | S | T | |
| 3. Miscellaneous Property in Sec. | S | T | R | |
| | | S | T | |

STATE OF MICHIGAN) RECORDED 14th DAY OF
 COUNTY OF LAKE) 1994 A.D. at
 O'clock 11:30 A.M.
James K. Dickson REGISTER OF DEEDS

Register of Deeds Stamp & File Number

- 4. Lot No. _____, Recorded Plat _____
- 5. Private Claims _____

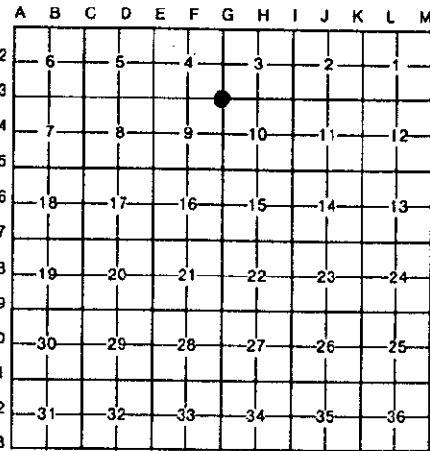

I, Robert L. Wetherell, in a field survey on October 27, 1994, do hereby certify that under requirements of P.A. 74, Michigan P.A. of 1970, the corner points mentioned in lines 1 and 2 above were in conformance with regulations and rules therefore as required in the current manual of survey instructions of the United States Department of the Interior, Bureau of Land Management or by a decree of a Court of Law and/or that the corner points mentioned in lines 3, 4 and 5 above were in conformance with the rules of the Michigan Board of Land Surveyors or by a Decree of a Court of Law, established, re-established, monumented, re-monumented, recovered, found as expressed below:

NOTE: Not more than 4 corners, all in the same town and range, may be recorded on this certificate.

A. Description of original monument and accessories and/or subsequent restoration:
 G-3 - Section corner common to Sections 3 & 4, T18N, R12W, Cherry Valley Twp., Lake Co., Mi.

- | | |
|---------------------------------|---|
| 1838 - John Hodgson, G.L.O. | 1973 - Carl Roser, L.S. 12028 |
| #1 - 10" Aspen S77°W 7 Links | L.C.R.C. L. 002, Pg. 257, recorded in 1975. Recovered Cedar Stake from three Frank Jones witnesses dated 1936, Jones had found stake and one U.S.B.T. (Tamarack with marks plain) replaced cedar stake with D.N.R. Aluminum capped pipe monument. <u>NOTE:</u> Frank Jones was not a surveyor but worked as a locator for U.S.F.S. in the 1930's. |
| #2 - 8" Tamarack N58°E 21 Links | #3 - 9" Cedar N35°W 17.8' |
| | #4 - 7" Cedar S15°E 8.0' |
| | #5 - 8" Cedar S30°W 27.3' |
| | #6 - Cedar Post South 16.5' |

B. Description of corner evidence found and/or method applied in restoring or reestablishing corner:

G-3 - Section corner common to Sections 3 & 4, T18N, R12W, Cherry Valley Twp., Lake Co., Mi.

I found D.N.R. aluminum capped iron in Luther-Baldwin swamp 500 feet more or less West of County Road. Condition of the accessories are as follows: #1 Gone, #2 Gone, #3 gone, #4 Found dead, #5 Found dead, #6 Found in good condition.

RATIFIED BY THE LAKE CO. PEER REVIEW GROUP
 IN ACCORDANCE WITH P.A. 345
 CHAIRMAN *[Signature]*
 DATE 11/8/94

C. Description of monument for corner and accessories established to perpetuate locating the position of the corner:

G-3 - Section corner common to Sections 3 & 4, T18N, R12W, Cherry Valley Twp., Lake Co., Mi.

- I accepted the D.N.R. Monument as a substantial monument for the corner, and is accepted as a careful and faithful perpetuation of the position of the original corner.
- 8" Cedar N30°W 37.50' (60d spike in N.E. side of tree)
- 8" Cedar N35°E 51.48' (60d spike in W. side of tree)
- 8" Cedar Post (with metal tag) South 16.07' (60d spike in W. side of post) (#6)
- 20" W. Pine N2°E 153.71' (60d spike in W. side of tree)

Signed by *Robert L. Wetherell*
 Surveyor's Michigan License No. 24624

Date 11/9/94

