

**SURVEY &
REMONUMENTATION**

AUG 31 1999

LAND CORNER RECORDATION CERTIFICATE

FILING REQUIREMENT OF ACT 74, Mich. P.A. 1970

RECORDED
LAKE COUNTY, MI.

LIBER 004 PAGE 0197

JUL 23 3 04 PM '99

SECTION

For corners in Lake _____	Located in:	Corner Code#
1. Public Land Survey	T 18 N R 12 W	H-1
	T _____ R _____	_____
	T _____ R _____	_____
	T _____ R _____	_____
2. Property Controlling In Section	T _____ R _____	_____
	S _____ T _____ R _____	_____
3. Miscellaneous Property in Sec.	S _____ T _____ R _____	_____
	S _____ T _____ R _____	_____
4. Lot No. _____ Recorded Plat	_____	_____
5. Private Claims	_____	_____

William H. Dickson
REGISTER OF DEEDS

Register of Deeds Stamp & File Number

	A	B	C	D	E	F	G	H	I	J	K	L	M
1													
2	6	5	4	3	2	1							
3													
4	7	8	9	10	11	12							
5													
6	18	17	16	15	14	13							
7													
8	19	20	21	22	23	24							
9													
10	30	29	28	27	26	25							
11													
12	31	32	33	34	35	36							
13													

I, Robert L. Wetherell, in a field survey on February 1, 1999, do hereby certify that under requirements of P.A. 74, Michigan P.A. of 1970, the corner points mentioned in lines 1 and 2 above were in conformance with regulations and rules therefore as required in the current manual of survey instructions of the United States Department of the Interior, Bureau of Land Management or by decree of a Court of Law and/or that the corner points mentioned in lines 3, 4, and 5 above were in conformance with the rules of the Michigan Board of Land Surveyors or by a Decree Of a Court of Law; established, re-established, monumented, re-monumented, recovered, found as expressed below:

H-1 - N. 1/4 Corner Section 3, T18N, R12W

A. Description of original monument and accessories and/or subsequent restoration:

1905 - G. H. Johnson, Co. Sur.
Set 1/16 Corner West of this corner.
No comment or information on 1/4 corner.

1973 - C. Roser, LS 12028
L.C.R.C. - L. 02, Pg. 149
"Established by B.L.M. instructions"
#1 - 5" Maple S60°W 34.9'
#2 - 8" Maple S8°W 13.9'
#3 - S 1/4 Cor. Sec. 34 - West 19.40'

1991 - R.L. Wetherell, LS 24624
Survey recorded L. 03, Pg. 269
Survey of NW 1/4-NW 1/4, Sec. 3
Found D.N.R. Monument
Same accessories as Roser's of 1973

B. Description of corner evidence found and/or method applied in restoring or reestablishing corner:

I found Roser's D.N.R. Monument (1- 1/4" pipe with aluminum disc cap).


Condition of the accessories are as follows: #1 Found stump, #2 Found Stump, #3 Found D.N.R. Monument.

C. Description of monument for corner and accessories established to perpetuate locating the position of the corner:

I accepted the D.N.R. Capped Pipe as a substantial marker for the corner. This position not established by original government surveyors. This monument is accepted as the best available evidence of the position of the corner.

- 5" Maple S19°W 15.41' (60d spike in E. side)
- 5" Maple N8°W 21.42' (60d spike in E. side)
- 3" W. Oak S87°E 35.40' (60d spike in N. side)
- D.N.R. Capped Pipe - West 19.40' (S. 1/4 Cor. Sec. 34, T19N, R12W) #3

RATIFIED BY THE LAKE CO. PEER REVIEW GROUP
IN ACCORDANCE WITH P.A. 345
CHAIRMAN *[Signature]*
DATE 7-20-99

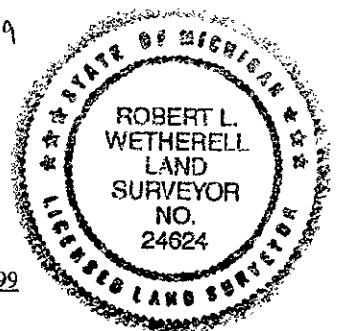

Signed by Robert L. Wetherell

Date July 21, 1999

Surveyor's Michigan License No. 24624