

**SURVEY &
REMONUMENTATION**

AUG 31 1999 LAND CORNER RECORDATION CERTIFICATE

FILING REQUIREMENT OF ACT 74, Mich. P.A. 1970

RECORDED
LAKE COUNTY, MI.

LIBER 004 PAGE 0198
Jul 23 3 04 PM '99

SECTION

For corners in Lake _____	Located in:	Corner Code#	
1. Public Land Survey	T 18N	R 12W	I-1
	T	R	
	T	R	
	T	R	
2. Property Controlling s in Section	T	R	
	S T	R	
3. Miscellaneous Property in Sec.	S T	R	
	S T	R	
4. Lot No. _____ Recorded Plat			
5. Private Claims _____			

Registrar H. Hodson
REGISTER OF DEEDS

Register of Deeds Stamp & File Number

I, Robert L. Wetherell, in a field survey on February 1, 1999, do hereby certify that under requirements of P.A. 74, Michigan P.A. of 1970, the corner points mentioned in lines 1 and 2 above were in conformance with regulations and rules therefore as required in the current manual of survey instructions of the United States Department of the Interior, Bureau of Land Management or by decree of a Court of Law and/or that the corner points mentioned in lines 3, 4, and 5 above were in conformance with the rules of the Michigan Board of Land Surveyors or by a Decree Of a Court of Law; established, re-established, monumented, re-monumented, recovered, found as expressed below:

	A	B	C	D	E	F	G	H	I	J	K	L	M
1													
2	6	5	4	3	2	1							
3													
4	7	8	9	10	11	12							
5													
6	18	17	16	15	14	13							
7													
8	19	20	21	22	23	24							
9													
10	30	29	28	27	26	25							
11													
12	31	32	33	34	35	36							
13													

I-1 - Section corner common to Sections 2 & 3, T18N, R12W

A. Description of original monument and accessories and/or subsequent restoration:

1838 - J. Hodgeson, G.L.O.
#1 - 7" Maple S37°W 22 Links
#2 - 9" W. Oak S59°E 33 Links

1973 - C. Roser, LS 12028
L.C.R.C. - L. 02, Pg. 149
"Established per standards of B.L.M. instruction"
Set D.N.R. Monument
#3 - 5" Maple S82°W 7.2'
#4 - 8" R. Oak S47°E 9.7'
#5 - Corner Section 34 & 35 T19N, R12W - West 30.23'

B. Description of corner evidence found and/or method applied in restoring of reestablishing corner:


I found the D.N.R. Monument (1- 1/2" Pipe with aluminum cap) 25 feet more or less West of old trail road.
Condition of the accessories are as follows: #1 Gone, #2 Gone, #3 Found Stump, #4 Gone, #5 Found badly bent.

C. Description of monument for corner and accessories established to perpetuate locating the position of the corner:

I accepted the D.N.R. Monument as a substantial marker for the corner, and is accepted as a careful and faithful re-establishment of the position of the original corner.

13" R. Oak N18°W 33.02' (60d spike in W. side)
14" R. Oak N23°E 30.92' (60d spike in W. side)
15" W. Oak N60°E 67.15' (60d spike in N. side)
4" W. Oak S39°E 54.06' (60d spike in S.W. side)

RATIFIED BY THE LAKE CO. PEER REVIEW GROUP
IN ACCORDANCE WITH P.A. 345
CHAIRMAN *RW*
DATE 7-22-99

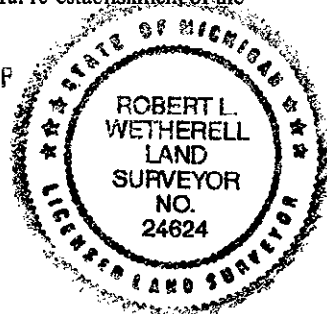

Signed by Robert L. Wetherell

Date July 21, 1999

Surveyor's Michigan License No. 24624