

REGISTERED
 103 01 003
 COMMISSION

LAND CORNER RECORDATION CERTIFICATE
 Filing Requirement of Act 74, Mich. P.A. 1970

LIBER003 PAGE0272

For corners in

Lake (County)	Located In:	Corner Code #
1. Public Land Survey	T 18N R 12W	I-3
	T _____ R _____	_____
	T _____ R _____	_____
	T _____ R _____	_____
	T _____ R _____	_____
2. Property Controlling in Section	S _____ T _____ R _____	_____
	S _____ T _____ R _____	_____
3. Miscellaneous Property in Sec.	S _____ T _____ R _____	_____
	S _____ T _____ R _____	_____

STATE OF MICHIGAN) RECORDED 14th DAY OF
 COUNTY OF LAKE) 1994 AD. at
 O'clock 11:30 A. M.
Shirley K. Dehn REGISTER OF DEEDS

Register of Deeds Stamp & File Number

4. Lot No. _____, Recorded Plat _____
 5. Private Claims _____

	A	B	C	D	E	F	G	H	I	J	K	L	M
2	6	5	4	3	2	1							
3									●				
4	7	8	9	10	11	12							
5													
6	18	17	16	15	14	13							
7													
8	19	20	21	22	23	24							
9													
10	30	29	28	27	26	25							
11													
12	31	32	33	34	35	36							
13													

I, Robert L. Wetherell, in a field survey on October 27, 1994, do hereby certify that under requirements of P.A. 74, Michigan P.A. of 1970, the corner points mentioned in lines 1 and 2 above were in conformance with regulations and rules therefore as required in the current manual of survey instructions of the United States Department of the Interior, Bureau of Land Management or by a decree of a Court of Law and/or that the corner points mentioned in lines 3, 4 and 5 above were in conformance with the rules of the Michigan Board of Land Surveyors or by a Decree of a Court of Law; established, re-established, monumented, re-monumented, recovered, found as expressed below:

NOTE: Not more than 4 corners, all in the same town and range, may be recorded on this certificate.

A. Description of original monument and accessories and/or subsequent restoration:

- I-3 - Section Corner common to Sections 2, 3, 10 & 11, T18N, R12W, Cherry Valley Twp., Lake Co., Mi.
 1838 - John Hodgson, G.L.O. 1973 - Carl Roser, L.S. 12028
 #1 - 30" Pine S46°E 52 Links Recorded L.C.R.C. Liber 002, Page 257, in 1975.
 #2 - 11" Pine N61°W 18 Links Found old buggy spring and two Frank Jones BT's, and one U.S.B.T (#1). Replaced spring with D.N.R. aluminum capped pipe monument.
 1936 - Frank Jones, Locator for U.S.F.S.
 #3 - 12" B. Oak N47°W 89.5 Links #5 - 13" B. Oak N45°W 58.8' (#3)
 #4 - 10" B. Oak S28°W 58 Links #6 - 9" R. Oak N25°E 12.3'
 #7 - 12" B. Oak S28°W 38.0' (#4)

B. Description of corner evidence found and/or method applied in restoring or reestablishing corner:

I-3 - Section Corner common to Sections 2, 3, 10 & 11, T18N, R12W, Cherry Valley Twp., Lake Co., Mi.
 I found the D.N.R. aluminum capped pipe monument. Condition of the accessories are as follows: #1 Found remains of stump. #2 Gone, #3 Found Stump, #4 Found in good condition, #5 Found stump, #6 found in good condition, #7 Found in good condition.


RATIFIED BY THE LAKE CO. PEER REVIEW GROUP
 IN ACCORDANCE WITH P.A. 345
 CHAIRMAN *R.L.W.*
 DATE 11/8/94

C. Description of monument for corner and accessories established to perpetuate locating the position of the corner:

I-3 - Section Corner common to Sections 2, 3, 10 & 11, T18N, R12W, Cherry Valley Twp., Lake Co., Mi.
 I accepted the D.N.R. aluminum capped pipe monument as a substantial monument for the corner, and is accepted as a careful and faithful perpetuation of the position of the original corner.
 11" R. Oak N29°E 12.76' (60d spike in N.W. side of tree) (O.B.T. #6)
 13" B. Oak S30°W 38.51' (60d spike in N.W. side of tree) (O.B.T. #4)
 12" W. Oak N89°E 31.80' (60d spike in N. side of tree)
 11" R. Oak N25°W 45.93' (60d spike in W. side of tree)

Signed by *Robert L. Wetherell*
 24624

Date 11/9/94

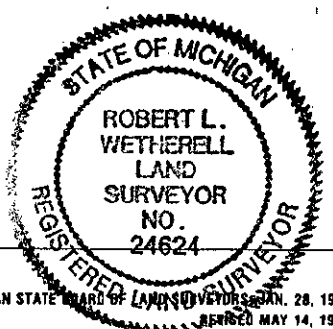

Surveyor's Michigan License No. _____