

MAY 16 1997

COMMISSION

LAND CORNER RECORDATION CERTIFICATE
Filing Requirement of Act 74, Mich. P.A. 1970

LIBER 003 PAGE 0419

For corners in

Table with columns: Lake (County), Located In: (T, R), Corner Code #. Includes entries for Public Land Survey, Property Controlling in Section, and Miscellaneous Property in Sec.

RECORDED LAKE COUNTY, MI.
Dec 16 10 27 AM 1996
REGISTER OF DEEDS

Register of Deeds Stamp & File Number

4. Lot No. , Recorded Plat
5. Private Claims

Grid table with columns A-M and rows 2-13. A black dot is located at the intersection of column I and row 9.

I, Robert L. Wetherell, in a field survey on November 12, 1996, do hereby certify that under requirements of P.A. 74, Michigan P.A. of 1970, the corner points mentioned in lines 1 and 2 above were in conformance with regulations and rules therefore as required in the current manual of survey instructions of the United States Department of the Interior, Bureau of Land Management or by a decree of a Court of Law and/or that the corner points mentioned in lines 3, 4 and 5 above were in conformance with the rules of the Michigan Board of Land Surveyors or by a Decree of a Court of Law; established, re-established, monumented, re-monumented, recovered, found as expressed below:

NOTE: Not more than 4 corners, all in the same town and range, may be recorded on this certificate.

A. Description of original monument and accessories and/or subsequent restoration:

I-9 - Section corner common to Sections 22, 23, 26 & 27, T18N, R12W, Lake Co., Mi.

1838 - John Hodgson, G.L.O.

#1 - 9" Pine S37°W 37 Links

#2 - 9" Pine N62°E 43 Links

1916 - George Johnson, County Surveyor

1/4" x 1" x 48" Iron Bar

#3 - 9" B. Oak N46°W 48'

#4 - 12" B. Oak Northerly (no distance given)

1972 - Clinton E. Cole, LS 17615

Survey recorded Liber 01, Page 265

1/2" x 1" Iron Bar

#5 - 12" B. Oak N56°W 60.74'

#6 - 14" B. Oak S54°W 43.86'

#7 - 22" B. Oak S78°W 33.65'

(SEE OVER FOR CONTINUATION OF "A")

B. Description of corner evidence found and/or method applied in restoring or reestablishing corner:

I-9 - Section corner common to Sections 22, 23, 26 & 27, T18N, R12W, Lake Co., Mi.

I found 1/2" pipe directly over 1/2" x 1" iron bar in the intersection of roads North, South and East. I recovered Accessories No. 5, 6 & 7 (Nail & Blass Washers), the bearings to accessories No. 5 & No. 6 were incorrectly reported by Cole in 1972.

Condition of the accessories are as follows: #1 Gone, #2 Gone, #3 Gone, #4 Gone, #5 Found in bad condition, #6 Found in good condition, #7 Found in good condition, #8 Found in good condition.

RATIFIED BY THE MICHIGAN DEED REVIEW GROUP
IN ACCORDANCE WITH P.A. 945
DATE 12-12-96

C. Description of monument for corner and accessories established to perpetuate locating the position of the corner:

I-9 - Section corner common to Sections 22, 23, 26 & 27, T18N, R12W, Lake Co., Mi.

I replaced the 1/2" pipe with a 3/4" x 14" re-bar with Lake County Brass Cap, and is accepted as a careful and faithful re-establishment of the position of the original corner.

26" B. Oak S88°W 33.70' (Nail & Blass Washer in N. side) #7


20" B. Oak S47°E 43.94' (60d spike in N.E. side) #6

11" R. Pine N41°E 49.89' (60d spike in N.W. side)

10" R Pine N64°W 61.24' (60d spike in S. side)

Signed by Robert L. Wetherell
Surveyor's Michigan License No. 24624

Date 12-13-1996

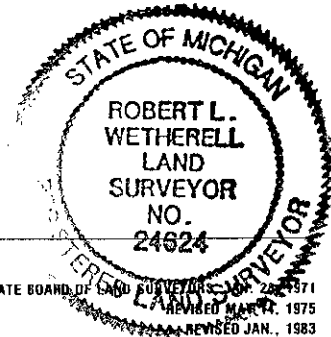

MAY 1 8 1997

COMMISSION

LIBER 003 PAGE 0419A

CONTINUATION OF "A" - DESCRIPTION OF ORIGINAL MONUMENT AND ACCESSORIES AND/OR SUBSEQUENT RESTORATION:

1978 - Carl Roser, DNR

L.C.R.C. - Liber 02, Page 339

"Found old corner of Record"

Raised with 1/2" Pipe

#5 - 14" B. Oak N60°E 60.72'

#6 - 17" B. Oak S50°E 43.83'

#7 - 25" B. Oak S85°W 33.66'

#8 - Iron Due West 33'

1978 - Robert L. Wetherell, LS 24624

Same accessories as Clinton E. Cole's in 1972.