

MAY 16 1997

COMMISSION

LAND CORNER RECORDATION CERTIFICATE
Filing Requirement of Act 74, Mich. P.A. 1970

LIBER 003 PAGE 0417

For corners in

Lake (County)	Located In:	Corner Code -#
1. Public Land Survey	T 18N R 12W	K-9
	T _____ R _____	_____
	T _____ R _____	_____
	T _____ R _____	_____
2. Property Controlling in Section	S _____ T _____ R _____	_____
	S _____ T _____ R _____	_____
3. Miscellaneous Property in Sec.	S _____ T _____ R _____	_____
	S _____ T _____ R _____	_____

RECORDED
LAKE COUNTY, MI.
Dec 16 10 27 AM '96
REGISTER OF DEEDS
Registrar M. DeLeon

Register of Deeds Stamp & File Number

- 4. Lot No. _____, Recorded Plat _____
- 5. Private Claims _____

I, Robert L. Wetherell in a field survey on November 13, 19 96, do hereby certify that under requirements of P.A. 74, Michigan P.A. of 1970, the corner points mentioned in lines 1 and 2 above were in conformance with regulations and rules therefore as required in the current manual of survey instructions of the United States Department of the Interior, Bureau of Land Management or by a decree of a Court of Law and/or that the corner points mentioned in lines 3, 4 and 5 above were in conformance with the rules of the Michigan Board of Land Surveyors or by a Decree of a Court of Law; established, re-established, monumented, re-monumented, recovered, found as expressed below:

NOTE: Not more than 4 corners, all in the same town and range, may be recorded on this certificate.

	A	B	C	D	E	F	G	H	I	J	K	L	M
2	6		5		4		3		2		1		
3													
4	7		8		9		10		11		12		
5													
6	18		17		16		15		14		13		
7													
8	19		20		21		22		23		24		
9													
10	30		29		28		27		26		25		
11													
12	31		32		33		34		35		36		
13													

A. Description of original monument and accessories and/or subsequent restoration:

K-9 - Section corner common to Sections 23, 24, 25 & 26, T18N, R12W, Lake Co., Mi.

1838 - John Hodgson, G.L.O.

1967 - George Blass, LS 5489

1979 - Clinton E. Cole, LS 17615

#1 - 16" Pine N61°E 18 Links

Survey No. 1240-67, showed corner.

#4 - 8" Maple N60°W 22.51'

#2 - 14" Pine S83°W 25 Links

No accessories given.

#5 - 8" R. Oak N4°W 24.56'

1910 - George West, Co. Sur.

#3 - 22" W. Pine Stump N75°W 39 Links

#6 - 10" W. Oak S55°E 21.34'


B. Description of corner evidence found and/or method applied in restoring or reestablishing corner:

K-9 - Section corner common to Sections 23, 24, 25 & 26, T18N, R12W, Lake Co., Mi.

I found an old 4" square concrete monument. I also recovered accessory No. 3 measuring N69°W 25.7 feet to center of stump.

Condition of the accessories are as follows: #1 Possible stump N71°E 13 feet to center, #2 Gone, #3 Found remains to stump, #4 Found in good condition, #5 Found in good condition, #6 Found in good condition.

CHIEF OF BUREAU OF LAND SURVEY GROUP
MICHIGAN DEPARTMENT OF NATURAL RESOURCES
CHIEF CLERK
DATE 12-12-96
R.L.W.

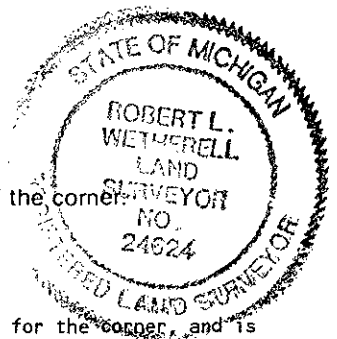

C. Description of monument for corner and accessories established to perpetuate locating the position of the corner:

K-9 - Section corner common to Sections 23, 24, 25 & 26, T18N, R12W, Lake Co., Mi.

The 4" Square Concrete Monument was in good condition so I accepted it as a substantial marker for the corner, and is accepted as a careful and faithful re-establishment of the position of the original corner.

- 10" R. Oak N1°W 24.39' (60d in E. side) #5
- 11" Maple N54°W 22.65' (60d in S.W. side) #4
- 10" W. Oak S54°E 21.35' (60d in S.W. side) #6
- 6" R. Pine S84°W 26.67' (60d in N. side)

Signed by *Robert L. Wetherell* Date 12-13-96
 Surveyor's Michigan License No. 24624