

JAN 12 1996

COMMISSION

LAND CORNER RECORDATION CERTIFICATE
Filing Requirement of Act 74, Mich. P.A. 1970

LIBER 003 PAGE 0328

For corners in

Lake (County)	Located In:		Corner Code -#
	18N	12W	
1. Public Land Survey	T	R	K-12
	T	R	
	T	R	
	T	R	
2. Property Controlling in Section	S	R	
	S	R	
3. Miscellaneous Property in Sec.	S	R	
	S	R	

REGISTER OF DEEDS
 Oct 30 2 45 PM '95
 RECORDED
 LAKE COUNTY, MI.

Register of Deeds Stamp & File Number

4. Lot No. _____, Recorded Plat _____
 5. Private Claims _____

	A	B	C	D	E	F	G	H	I	J	K	L	M
2	6	5	4	3	2	1							
3													
4	7	8	9	10	11	12							
5													
6	18	17	16	15	14	13							
7													
8	19	20	21	22	23	24							
9													
10	30	29	28	27	26	25							
11													
12	31	32	33	34	35	36							
13													

I, Robert L. Wetherell, in a field survey on August 25, 1995, do hereby certify that under requirements of P.A. 74, Michigan P.A. of 1970, the corner points mentioned in lines 1 and 2 above were in conformance with regulations and rules therefore as required in the current manual of survey instructions of the United States Department of the Interior, Bureau of Land Management or by a decree of a Court of Law and/or that the corner points mentioned in lines 3, 4 and 5 above were in conformance with the rules of the Michigan Board of Land Surveyors or by a Decree of a Court of Law; established, re-established, monumented, re-monumented, recovered, found as expressed below:

NOTE: Not more than 4 corners, all in the same town and range, may be recorded on this certificate.

A. Description of original monument and accessories and/or subsequent restoration:

K-12 - 1/4 corner common to Sections 35 and 36, T18N, R12W

- | | | |
|--|-------------------------------------|---|
| <u>1838 - John Hodgson, D.S., G.L.O.</u> | <u>1942 - George Blass, LS 5489</u> | <u>1965 - Robert Griffin, LS 13584</u> |
| Set wood post | Found 3/4" Iron Pipe | Replaced 3/4" iron by Blass with a 5" Square Conc. Post, 36" long w/Brass Cap |
| #1 - 7" Pine S24°E 13 Links (8.58') | #3 Tri. B. Oak S75°E 39.00' | #6 - Cedar Post East 33' |
| #2 - 10 Pine N40°W 16 Links (10.56') | #4 - 20" B. Oak S35°W 58.40' | #7 - 3" R. Pine N52°E 60.74' |
| | #5 - 10" Tw. W. Oak N58°W 66.00' | #8 - Tw. B. Oak S75°E 38.92' |
| | | #9 - 4" W. Oak S22°E 72.12' |
| | | #10 - 22" B. Oak S35°W 58.28' |
| | | #11 - 5" R. Pine S75°W 114.25' |
| | | #12 - Power Pole N76°W 111.17' |

B. Description of corner evidence found and/or method applied in restoring or reestablishing corner:

K-12 - 1/4 corner common to Sections 35 and 36, T18N, R12W

On August 24, 1995, I found a 5" square concrete monument with brass cap set by Robert Griffin one foot below road surface. I searched for other irons or markers also any other evidence, but found nothing to dispute this location for the 1/4 corner.

Condition of the witnessess are as follows: #1 gone, #2 Gone, #3 Found in good condition, #4 Found stump, #5 Gone, #6 Found in good condition, #7 Found in good condition, #8 Found in good condition, #9 Found in good condition, #10 Found stump, #11 Found in good condition, #12 Gone.

C. Description of monument for corner and accessories established to perpetuate locating the position of the corner:

K-12 - 1/4 corner common to Sections 35 and 36, T18N, R12W


I accepted the 5" x 36" Concrete Monument and is accepted as a careful and faithful re-establishment of the position of the original corner.

- 16"-18" Tw. B. Oak S75°E 39.92' (60d spike in N.W. side) (#3 & #8)
- 8" R. Pine N52°E 60.74' (10" dock spike in N.W. side) (#7)
- 6" W. Oak S22°E 72.12' (10" dock spike in N.E. side) (#9)
- 12" R. Pine S75°W 114.25' (10" dock spike in N.W. side) (#11)
- Power Pole N68°W 62.22' (60d spike in N.E. side)

Signed by Robert L. Wetherell

Date 10-25-95

Surveyor's Michigan License No. 24624

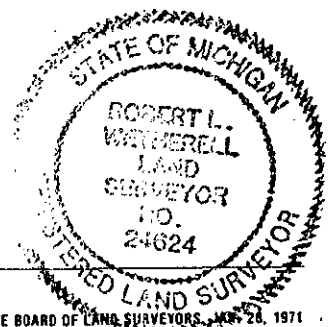

RATIFIED BY THE LAKE CO. PEER REVIEW GROUP
 IN ACCORDANCE WITH P.A. 345
 CHAIRMAN R. W.
 DATE 10-23-95