

**SURVEY &  
REMONUMENTATION**

**AUG 31 1999 LAND CORNER RECORDATION CERTIFICATE**

FILING REQUIREMENT OF ACT 74, Mich. P.A. 1970

**SECTION**

For corners in Lake _____	Located in:	Corner Code#
1. Public Land Survey	T 18N R 12W	L-13
	T R	
	T R	
	T R	
2. Property Controlling s in Section	T R	
	S T R	
3. Miscellaneous Property in Sec.	S T R	
	S T R	
4. Lot No. _____ Recorded Plat		
5. Private Claims		

RECORDED  
LAKE COUNTY, MI.  
LIBER 004; PAGE 0201  
JUL 23 3 04 PM '99

*Shirley H. Dickson*  
REGISTER OF DEEDS

Register of Deeds Stamp & File Number

	A	B	C	D	E	F	G	H	I	J	K	L	M
1													
2	6	5	4	3	2	1							
3													
4	7	8	9	10	11	12							
5													
6	18	17	16	15	14	13							
7													
8	19	20	21	22	23	24							
9													
10	30	29	28	27	26	25							
11													
12	31	32	33	34	35	36							
13													

I, Robert L. Wetherell, in a field survey on January 1, 1999, do hereby certify that under requirements of P.A. 74, Michigan P.A. of 1970, the corner points mentioned in lines 1 and 2 above were in conformance with regulations and rules therefore as required in the current manual of survey instructions of the United States Department of the Interior, Bureau of Land Management or by decree of a Court of Law and/or that the corner points mentioned in lines 3, 4, and 5 above were in conformance with the rules of the Michigan Board of Land Surveyors or by a Decree Of a Court of Law; established, re-established, monumented, re-monumented, recovered, found as expressed below:

**L-13 - S. 1/4 Corner Sec. 36, T18N, R12W**

**A. Description of original monument and accessories and/or subsequent restoration:**

**1837 - J. Hodgson, G.L.O.**  
#1 - 10" Aspen N56°W 10 Links  
#2 - 7" Pine N40°E 28 Links

**1974 - E. McCombs, Consumers Power co.**  
Found Steel Shaft  
#3 - 14" Oak N10°W 32.45'  
#4 - 10" Oak South 4.69'  
#5 - 12" Oak N20°E 30.25'

**B. Description of corner evidence found and/or method applied in restoring of reestablishing corner:**

I found a 1" x 1' Axle Shaft that fits McComb's measurements on the South line of Section 36 very well.

**McComb's**  
East - 2619.36'  
West - 2634.03'

**Wetherell**  
East 2618.96'  
West - 2634.08'


Condition of the accessories are as follows: #1 Gone, #2 Gone, #3 Found Stump #4 Found in good condition #5 Found in poor condition.

**C. Description of monument for corner and accessories established to perpetuate locating the position of the corner:**

I replaced the 1" Shaft with a 3/4" x 24" re-bar with Lake County Remon Cap, and is accepted as a careful and faithful re-establishment of the position of the original corner.

11" W. Oak S05°E 4.80' 60d spike in E. side) #4  
11" B. Oak S40°E 15.69' (60d spike in S.W. side)  
13" B. Oak S62°W 22.82' (60d spike in N. side)  
3/4" x 24" Capped Iron - East 18.48' (N. 1/4 Cor. Section 1, T17N, R12W)

RATIFIED BY THE LAKE CO. PEER REVIEW GROUP  
IN ACCORDANCE WITH P.A. 345  
CHAIRMAN *R.L.W.*  
DATE *7-20-99*

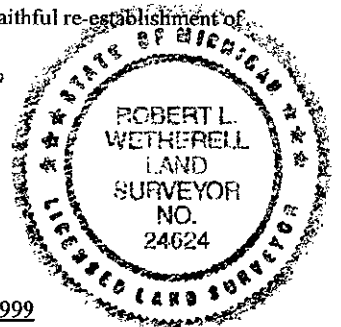

Signed by *Robert L. Wetherell*

Date July 21, 1999

Surveyor's Michigan License No. 24624