

# LAND CORNER RECORDATION CERTIFICATE


Filing Requirement of Act 74, Mich. PA 1970

For Corners In:			
Lake _____	Located In _____	Corner Code # _____	
(County) _____			
1. Public Land Survey	T _____ R _____		
	T _____ R _____		
2. Property Controlling in Section	S <u>27</u> T 18N R 12W CSS 1/64		
	S <u>27</u> T 18N R 12W 16		
3. Miscellaneous Property in Section	S _____ T _____ R _____		
	S _____ T _____ R _____		
4. Lot No: _____	Recorded Plat: _____		
5. Private Claims: _____			

Register of Deeds Stamp & File Number

I, Craig W. McVean, in a field survey on March 31, 2009 do hereby state that under requirements of PA 74, Michigan PA of 1970, the corner points mentioned in lines 1 and 2 above were in conformance with regulations and rules therefore as required in the current manual of survey instructions of the United States Department of the Interior, Bureau of Land Management or by a decree of a Court of Law and/or that the corner points mentioned in lines 3, 4 and 5 above were in conformance with the rules of the Michigan Board of Land Surveyors or by a Decree of a Court of Law; established, re-established, monumented, recovered, found as expressed below:

**NOTE: Not more than 2 corners, all in the same town and range, may be recorded on this certificate.**

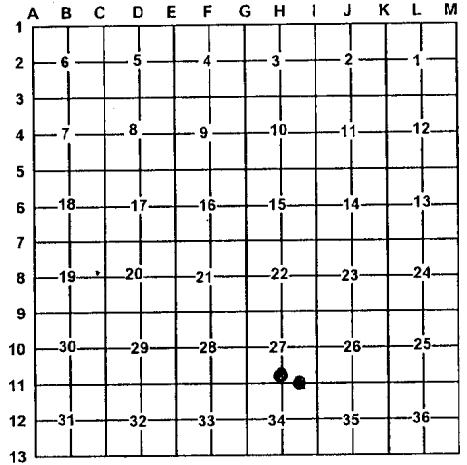

**A. Description of original monument and accessories and/or subsequent restoration:**

16 - 1979 - LCRC - L. 2, p. 348 - C. F. Roser. Set 5/8" x 40" rod CSS 1/64 - None  
 with RLS cap per Standard BLM instructions. Center E-W  
 Gravel Road N 2'±. Set Cedar post with loc. tag N. 33  
 1) 11" W. Oak S21°E 56.6'  
 2) 12" W. Oak N34°E 74.2'

**B. Description of corner evidence found and/or method applied in restoring or re-establishing corner:**

16 - E 1/16 Corner common to Sec. 27 & 34 - Fd. 5/8" rebar 2' S. CSS 1/64 Corner, Sec. 27 - Being the SE Corner of the N 1/2 of the  
 of Centerline of E-W gravel road per Roser. Both BT's in SE 1/4 of the SW 1/4, Sec. 27 - Set 2" Alum. Cap on 5/8" x 34"  
 place. Cedar post gone. 5/8" rebar accepted as the best rebar per Standard BLM procedure. N-S single strand fence  
 available evidence of the position of the corner. is 0.5'± West.

**C. Description of monument for corner and accessories established to perpetuate locating the position of the corner:**

16 - 5/8" rebar - Down 1.4' CSS 1/64 - Stamped 2" Alum. Cap on 5/8" x 34" rebar  
 South 33' to set Blue Carsonite Post with loc. tag N60°W 13.24' to set N & T in SW side 12" W. Oak  
 North 33.22' to fd. 1/2" CIR #17615 S73°W 11.93' to set N & T in S. side 7" W. Oak  
 S22°E 57.00' to set N & T in E. side 18" W. Oak (#1) S61°E 10.07' to set N & T in N. side 9" W. Pine  
 S60°W 63.21' to set N & T in SE side 6" W. Pine S16°E 18.98' to set N & T in W. side 15" W. Pine  
 N34°E 74.74' to set PK & Tag in E. side 16" W. Oak (#2) Set Blue Carsonite Post with loc. tag 1' NW

Signed by: Craig W. McVean  
 Surveyor's Michigan License No.: 39088

Date: 4/21/2009

