


STATE OF MICHIGAN
DEPARTMENT
OF
NATURAL RESOURCES

LAND CORNER RECORD

LAKE COUNTY
T 18 N R 13 W

DESCRIPTION OF CORNER West 1/4 Corner, Section 11
CORNER MONUMENT Found Forest Service monument buried 6"
DATE MONUMENT PLACED AND WITNESSED 5-8-72


WITNESSES TO CORNER.....	* 7" Oak	S 54 W	142.81'
	* Tel. Pole	N 29 W	120.87'
	* Oak	N 60 W	96.00'
	AND ^{CL} M-37	Due E	13'

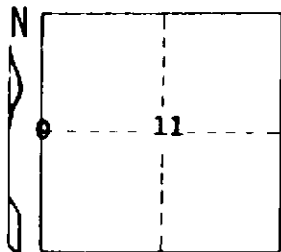

CIRCLE CORNER REGISTERED

*B. Griffin's BTs bearings & meas. all ok.

DESCRIPTION IN DETAIL AS TO HOW CORNER WAS LOCATED AND IDENTIFIED OR RESTORED.
Recovered U.S. Forest Service monument.

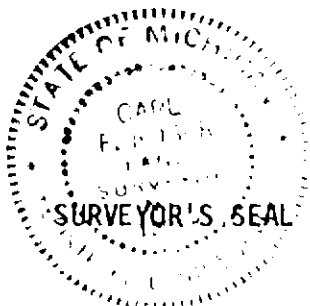

SIGNED

Carl F. Rooser

DATE

5-15-72

DISTRIBUTION:

REGISTERED LAND SURVEYOR 12028

Forestry Division, Lansing