

STATE OF MICHIGAN
DEPARTMENT
OF
NATURAL RESOURCES

LAND CORNER RECORD


LAKE		COUNTY	
T	18 N	R	13 W

DESCRIPTION OF CORNER NW Corner, Section 11

CORNER MONUMENT Found Forest Service monument buried 1'

DATE MONUMENT PLACED AND WITNESSED 5-8-72

WITNESSES TO CORNER..... Large screw in side 9" Oak N 65 E 94.4'

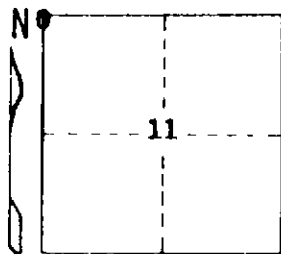

Nail & MSHD tag in Tel. Pole S 40 E 96.4'


Large Rock 3'x3'x3' chiseled X on top S 45 W 71.9'

AND CL M-37 Due W 13 1/2'

CIRCLE CORNER REGISTERED

DESCRIPTION IN DETAIL AS TO HOW CORNER WAS LOCATED AND IDENTIFIED OR RESTORED.

Recovered U.S. Forest Service Monument of record.

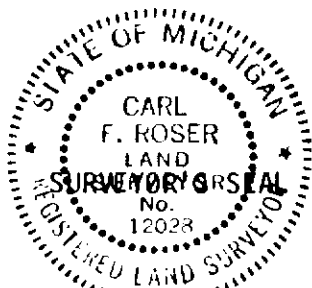

DISTRIBUTION:

Forestry Division, Lansing

SIGNED

Carl F. Roser
REGISTERED LAND SURVEYOR 12028

DATE

5-15-72