


STATE OF MICHIGAN
DEPARTMENT
OF
NATURAL RESOURCES

LAND CORNER RECORD

LAKE COUNTY
T 19 N R 13 W

DESCRIPTION OF CORNER East 1/4 corner, Section 2
CORNER MONUMENT Set DNR monument and 3" Oak Post
DATE MONUMENT PLACED AND WITNESSED 5-4-72

WITNESSES TO CORNER..... B. Oak 11" S 50 E 44.1'

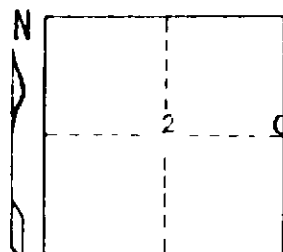


B. Oak 10" N 5 E 32.8'

AND

CIRCLE CORNER REGISTERED

DESCRIPTION IN DETAIL AS TO HOW CORNER WAS LOCATED AND IDENTIFIED OR RESTORED.

Re-established corner per standard BLM instructions.

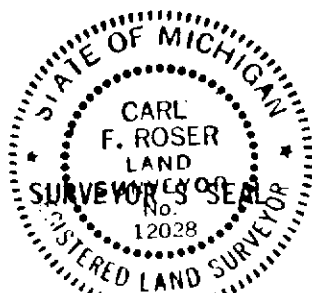

DISTRIBUTION:

SIGNED

Carl F. Roser
REGISTERED LAND SURVEYOR 12028

DATE

5-11-72

Forestry Division, Lansing