

STATE OF MICHIGAN  
DEPARTMENT  
OF  
NATURAL RESOURCES

LAND CORNER RECORD


\_\_\_\_\_ TANE COUNTY  
T 18 N R 15 W

DESCRIPTION OF CORNER N 1/16 on E line Section 2

CORNER MONUMENT Set 1" x 36" Pipe & 5" sq'ed. oak post

DATE MONUMENT PLACED AND WITNESSED 5-15-72

WITNESSES TO CORNER.....

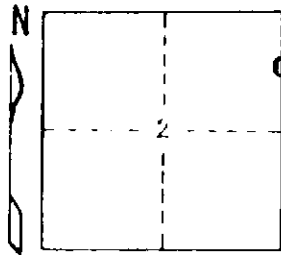

W. Oak 20" N 65 W 65.3'


W. Oak 10" S 50 W 33.8'

AND

CIRCLE CORNER REGISTERED

DESCRIPTION IN DETAIL AS TO HOW CORNER WAS LOCATED AND IDENTIFIED OR RESTORED.

**Corner established per standard BIM instructions.**

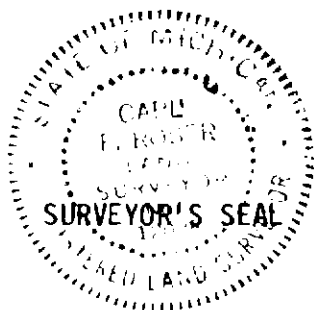

SIGNED

*Carl F. Rover*  
REGISTERED LAND SURVEYOR 12028

DATE

5-21-72

DISTRIBUTION:

Forestry Division, Lansing