


STATE OF MICHIGAN
DEPARTMENT
OF
NATURAL RESOURCES

LAND CORNER RECORD

_____ TATE _____ COUNTY
T 18 N R 13 W

DESCRIPTION OF CORNER North 1/4 corner, Section 11
CORNER MONUMENT Ed. 1 1/4" pipe & old glass lamp base. Added DNR mon. & cedar guard post.
DATE MONUMENT PLACED AND WITNESSED 6-28-72
WITNESSES TO CORNER.....

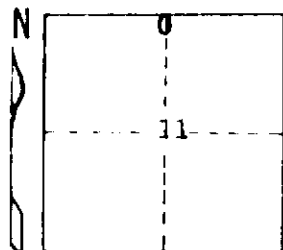


7" Oak S 75 E 4.6'
6" Maple S 31 E 9.6'
8" Oak S 25 W 16.8'
AND 6" Oak N 66 W 33.6'

CIRCLE CORNER REGISTERED

DESCRIPTION IN DETAIL AS TO HOW CORNER WAS LOCATED AND IDENTIFIED OR RESTORED.

Found recovered glass corner of record.

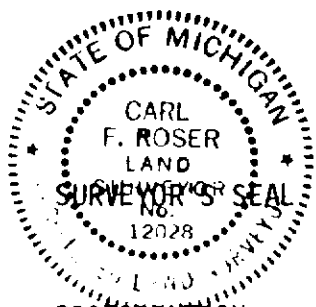

DISTRIBUTION:

Forestry Division, Lansing

SIGNED

Carl F. Roser
REGISTERED LAND SURVEYOR 12028

DATE

7-5-72