


STATE OF MICHIGAN
DEPARTMENT
OF
NATURAL RESOURCES

LAND CORNER RECORD

_____ LAKE _____ COUNTY
T 18 N R 13 W

DESCRIPTION OF CORNER North 1/4 on North line of Section 2
CORNER MONUMENT Found 1/2" x 1/2" x 15" sq. ir. & set Dept. monument 8" deep in
ctr. of E-W sand trail road
DATE MONUMENT PLACED AND WITNESSED 6-30-72

WITNESSES TO CORNER..... 17" B. Pine S 45 W 20.2'
6" B. Oak S 05 E 42.2'
Cedar post w/ location tag Due N 33'

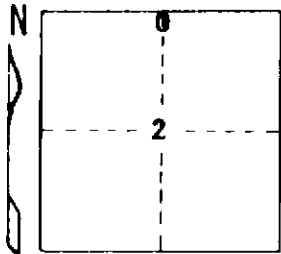


AND

CIRCLE CORNER REGISTERED

DESCRIPTION IN DETAIL AS TO HOW CORNER WAS LOCATED AND IDENTIFIED OR RESTORED.

Accepted existing recovered corner from previous Blass survey of record.

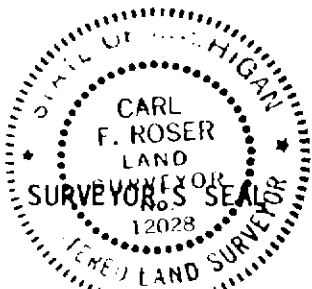

DISTRIBUTION:

Forestry Division, Lansing

SIGNED

Carl F. Roser

DATE

7-7-72

REGISTERED LAND SURVEYOR **12028**